

MARSHALL
J 102
3-25-74

MISSISSIPPI
 BOARD OF WATER COMMISSIONERS **CODED**
 416 North State Street
 Jackson, Mississippi 39201

WATER WELL DRILLERS LOG

March 25 19 94 Earl Jones Well Co Marshall
 date well completed firm name county well located

LANDOWNER:

Robert S. Smith

description of formations encountered

from

to

Pyhalia miss Rt.
 (mailing address)

Topsoil + clay
sand
clay
sand
clay
sand

0 12
12 40
40 43
43 80
80 84
84 132

WELL LOCATION:

sec. 26 T. 3 R. 4 E.
3 1/2 miles SW. of Red Bank
 (distance) (direction) (nearest town)

WELL PURPOSE: Home
 (home, irrigation, municipal, industrial)

WELL COMPLETION DATA:

- (1) diameter (inches) 4"
- (2) total depth (feet) 132
- (3) static water level (feet) 70 below/above top of ground.
- (4) casing plastic 126
 (material) (depth)
4 if telescope see back.
 (size)
- (5) screen 6' 126
 (length) (depth to top)
4" plastic gravel
 (size) (material)
- (6) pump 1/2 12
 (HP) (yield gpm)
Electric
 (type power)
- (7) electric log no
 (yes or no)

CODED

(organization running log)


(8) how well bottom plugged
plastic cap

DRILLERS REMARKS:

RECEIVED
 APR 15 1974
 MISS. BD. OF WATER COMMISSIONERS

If well telescopes please
sketch and show depths.

GROUND LEVEL

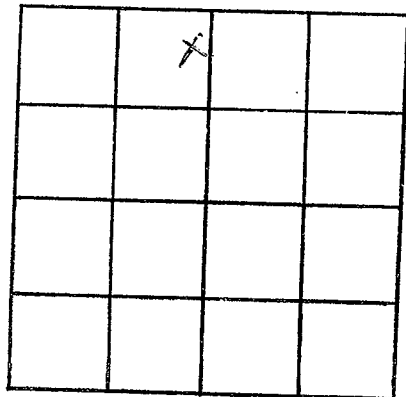

SECTION 2-6

Please indicate well location X.

ADDITIONAL INFORMATION

If more than one screen,
show locations of each on sketch.