

MARSHALL
J 103
11-2-73

MISSISSIPPI
 BOARD OF WATER COMMISSIONERS
 416 North State Street **CODED**
 Jackson, Mississippi 39201

WATER WELL DRILLERS LOG

11-2-73 1973 Bob Smith Marshall
 date well completed firm name county well located

LANDOWNER:
Justice Tolson
Red Oak, Miss.
 (mailing address)

description of formations encountered	from	to
top soil	0	5
red clay	15	45
red sand	45	65
white sand	65	120

WELL LOCATION:
 sec 24 T 3 N R 4 E
 (S) (W)
0 miles South of red bank
 (distance) (direction) (nearest town)

WELL PURPOSE: Home
 (home, irrigation, municipal, industrial)

WELL COMPLETION DATA:

(1) diameter (inches) 4

(2) total depth (feet) 120

(3) static water level (feet) 10 below above top of ground.

(4) casing Plastic 120
 (material) (depth)
 (size) If telescope see back.

(5) screen 50 100
 (length) (depth to top)
4 Plastic
 (size) (material)

(6) pump 1/2 10
 (HP) (yield gpm)
Electric
 (type power)

(7) electric log no
 (yes or no)

(organization running log)

(8) how well bottom plugged plugged


DRILLERS REMARKS:

CODED

APR - 6 1974

If well telescopes please sketch and show depths.

GROUND LEVEL

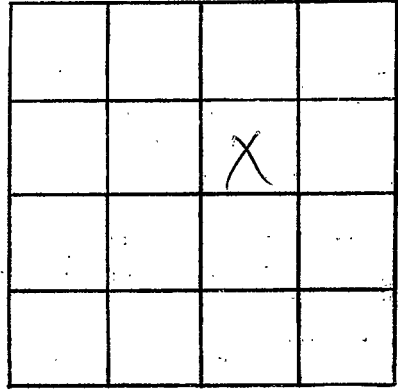

SECTION _____

Please indicate well location X.

ADDITIONAL INFORMATION

If more than one screen, show locations of each on sketch.