

MARSHALL
J 106
3-11-74

MISSISSIPPI
 BOARD OF WATER COMMISSIONERS
 416 North State Street
 Jackson, Mississippi 39201

WATER WELL DRILLERS LOG

CODED

3-11-1974 Shirley Lee Wells Marshall
 date well completed firm name county well located

LANDOWNER:

Lonell R. Lonell-
Pt 2, Bysalia, Miss
 (mailing address)

description of formations encountered

from to

Red Clay	0	15
Red clay + Sand	15	30
Red Sand	30	45
white sand + white clay	45	60
white sand	60	75
white sand + clay	75	90
white sand	120	135

WELL LOCATION:

sec. 2 T. 3 N. R. 4 E.
2 1/2 miles SE of Bysalia
 (distance) (direction) (nearest town)

WELL PURPOSE:

Home
 (home, irrigation, municipal, industrial)

WELL COMPLETION DATA:

- (1) diameter (inches) 4 in.
- (2) total depth (feet) 135
- (3) static water level (feet) 85 below top of ground.
- (4) casing Plastic, 135.
 (material) (depth)
 (size) if telescope see back.
- (5) screen 4 ft, 131
 (length) (depth to top)
4 in., Galvanel
 (size) (material)
- (6) pump 3/4, 10
 (HP) (yield gpm)
Electric 230
 (type power)
- (7) electric log no
 (yes or no)

(organization running log)


(8) how well bottom plugged Cap

DRILLERS REMARKS:

APR 17 1974

If well telescopes please sketch and show depths.

GROUND LEVEL

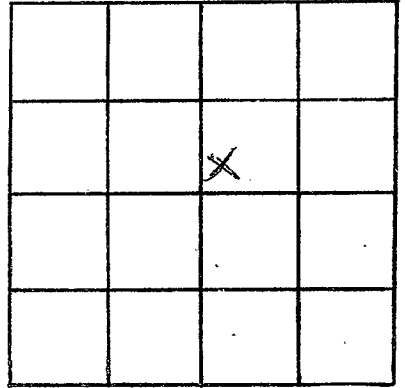

SECTION 7

Please indicate well location X.

ADDITIONAL INFORMATION

If more than one screen,
show locations of each on sketch.