

MARSHALL

J107

5-28-74

MISSISSIPPI BOARD OF WATER COMMISSIONERS  
416 North State Street  
Jackson, Mississippi 39201

WATER WELL DRILLERS LOG CODED

May 28

1974

Earl Jones Well Co.

Marshall

date well completed

firm name

county well located

LANDOWNER:

Robert Barber

Red Bank Miss. Rt 1  
(mailing address)

WELL LOCATION:

sec. 4 T. 3 N. R. 4 E.  
S. W. Victoria  
1/4 miles E. of (nearest town)

WELL PURPOSE: Home  
(home, irrigation, municipal, industrial)

WELL COMPLETION DATA:

- (1) diameter (inches) 4"
- (2) total depth (feet) 190
- (3) static water level (feet) 150 below top of ground.
- (4) casing plastic (material), 184 (depth), 4" (size) if telescope see back.
- (5) screen 6" (length), 184 (depth to top), 4" (size), plastic gravel (material)
- (6) pump 3/4 (HP), 15 (yield gpm), Electric (type power)
- (7) electric log no (yes or no)
- (organization running log)
- (8) how well bottom plugged plastic cap


description of formations encountered

from

to

|                      |     |     |
|----------------------|-----|-----|
| <del>0</del> to clay | 0   | 10  |
| rock                 | 10  | 15  |
| sand                 | 15  | 40  |
| clay                 | 140 | 150 |
| sand                 | 150 | 170 |
| clay                 | 170 | 175 |
| sand                 | 175 | 190 |

CODED

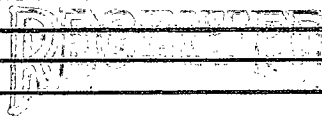


JUN - 3 1974

MISS. Bd. of WATER COMMISSIONERS

DRILLERS REMARKS:

If well telescopes please sketch and show depths.

GROUND LEVEL

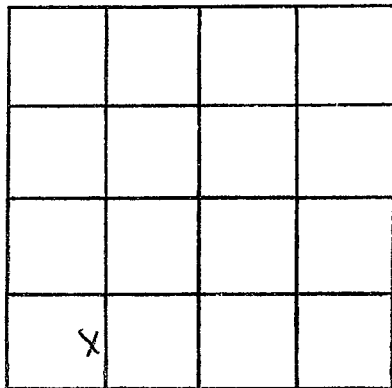

SECTION 7

Please indicate well location X.

ADDITIONAL INFORMATION

If more than one screen,  
show locations of each on sketch.