

**MARSHALL**  
**J110**  
**8-9-74**

MISSISSIPPI  
 BOARD OF WATER COMMISSIONERS **CODED**  
 416 North State Street  
 Jackson, Mississippi 39201

**WATER WELL DRILLERS LOG**

8-9 1974 Bob Smith & Son Marshall  
 date well completed firm name county well located


LANDOWNER:	description of formations encountered	from	to
<u>Harry McQueen</u>			
<u>Victoria, Miss.</u> (mailing address)	<u>clay</u>	<u>14'</u>	<u>30'</u>
WELL LOCATION:	<u>Red sand</u>	<u>30'</u>	<u>45'</u>
sec. <u>16</u> T. <u>3</u> N R. <u>4</u> E <small>(S) (W)</small>	<u>white sand</u>	<u>45'</u>	<u>105'</u>
<u>1 1/2</u> miles <u>South</u> of <u>Victoria</u> (distance) (direction) (nearest town)	<u>gumbo (Blue clay)</u>	<u>105'</u>	<u>120'</u>
WELL PURPOSE:	<u>white sand</u>	<u>120'</u>	<u>195'</u>
<u>Home</u> (home, irrigation, municipal, industrial)			
WELL COMPLETION DATA:			
(1) diameter (inches) <u>4"</u>			
(2) total depth (feet) <u>195'</u>			
(3) static water level (feet) <u>92'</u> below top of ground.			
(4) casing <u>plastic</u> <u>195'</u> (material) (depth)			
(size) <u>          </u> If telescope see back.			
(5) screen <u>10'</u> <u>185'</u> (length) (depth to top)			
<u>4"</u> <u>plastic</u> (size) (material)			
(6) pump <u>3/4</u> <u>10</u> (HP) (yield gpm)			
<u>electric</u> (type power)			
(7) electric log <u>no</u> (yes or no)			
(organization running log)			
(8) how well bottom plugged <u>plugged</u>			
DRILLERS REMARKS:			

**CODED**

**RECEIVED**  
 15  
 AUG 10 1974

If well telescopes please sketch and show depths.

GROUND LEVEL

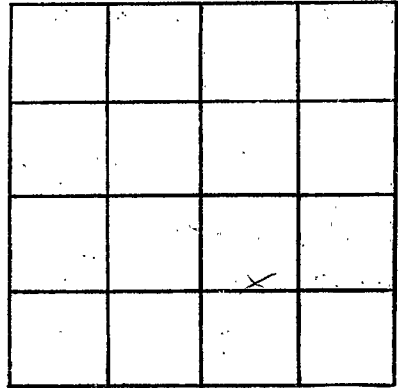

SECTION 16

Please indicate well location X.

ADDITIONAL INFORMATION

If more than one screen, show locations of each on sketch.