

MARSHALL
J III
8-19-74


MISSISSIPPI
BOARD OF WATER COMMISSIONERS
416 North State Street
Jackson, Mississippi 39201

CODED

WATER WELL DRILLERS LOG

8/14/74 1974 Bob Smith Marshall
date well completed firm name county well located

LANDOWNER: <u>Ralph Deckey</u>	description of formations encountered	from	to
<u>Byherlia, MS</u> (mailing address)	<u>Top Soil</u>	<u>0</u>	<u>10</u>
	<u>Red Sand</u>	<u>10</u>	<u>22</u>
	<u>Yellow Sand</u>	<u>22</u>	<u>40</u>
	<u>fine gravel</u>	<u>40</u>	<u>52</u>
	<u>White Sand</u>	<u>52</u>	<u>145</u>
WELL LOCATION: sec <u>30</u> T <u>3</u> N R <u>4</u> E <u>2</u> miles <u>N. E.</u> of <u>Watson</u> (distance) (direction) (nearest town)			
WELL PURPOSE: <u>Home</u> (home, irrigation, municipal, industrial)			
WELL COMPLETION DATA:			
(1) diameter (inches) <u>4" in.</u>			
(2) total depth (feet) <u>145 ft.</u>			
(3) static water level (feet) <u>40</u> below top of ground.			
(4) casing <u>plastic</u> , <u>145'</u> (material) (depth)			
(size) if telescope see back.			
(5) screen <u>10'</u> , <u>135'</u> (length) (depth to top)			
<u>4" plastic</u> (size) (material)			
(6) pump <u>1/2</u> , <u>10'</u> (HP) (yield gpm)			
<u>electric</u> (type power)			
(7) electric log <u>no</u> (yes or no)			
(organization running log)			
(8) how well bottom plugged <u>plugged</u>			
DRILLERS REMARKS:			

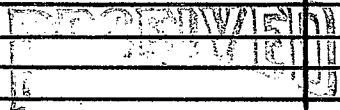


AUG 20 1974

MISS. BD. OF WATER COMM.

If well telescopes please sketch and show depths.

GROUND LEVEL

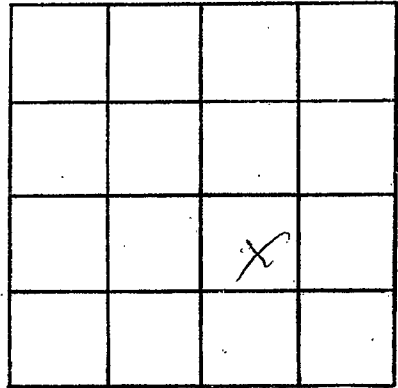

SECTION 30

Please indicate well location X.

ADDITIONAL INFORMATION

If more than one screen, show locations of each on sketch.