

MARSHALL
 J13
 8-25-74

MISSISSIPPI
 BOARD OF WATER COMMISSIONERS
 416 North State Street
 Jackson, Mississippi 39201 CODED

WATER WELL DRILLERS LOG

8-25-1974 date well completed
 N. Hobbs Bros. Wells firm name
 Marshall county well located

LANDOWNER: Victoria
 Village - College Ave.
 Holly Springs, Miss.
 (mailing address)

description of formations encountered	from	to
Red Clay	0	15
White Sand	15	60
White Sand & Clay	60	90
White Sand	90	160

WELL LOCATION:
 sec. 8 T 3 N R 4 E
 1 miles SW of Victoria
 (distance) (direction) (nearest town)

WELL PURPOSE:
 (home, irrigation, municipal, industrial)

WELL COMPLETION DATA:

- (1) diameter (inches) 4 1/2
- (2) total depth (feet) 160
- (3) static water level (feet) 80 below top of ground.
- (4) casing Plastic, 160
 (material) (depth)
- (size) if telescope see back.
- (5) screen 8, 152
 (length) (depth to top)
4 1/2, Gravel
 (size) (material)
- (6) pump 1, 10
 (HP) (yield gpm)
Electric 220
 (type power)
- (7) electric log No
 (yes or no)

(organization running log)


(8) how well bottom plugged cap

DRILLERS REMARKS:

RECEIVED
 SEP 25 1974

If well telescopes please sketch and show depths.

GROUND LEVEL

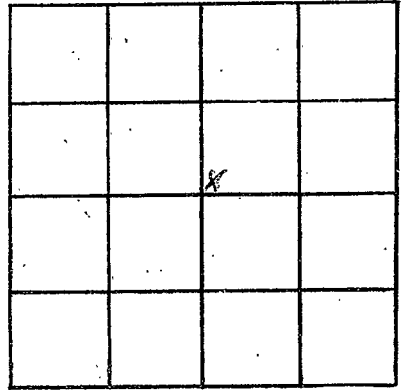

SECTION 8

Please indicate well location X.

ADDITIONAL INFORMATION

If more than one screen,
show locations of each on sketch.