

MISSISSIPPI
BOARD OF WATER COMMISSIONERS
416 North State Street
Jackson, Mississippi **CODED**

WATER WELL DRILLERS LOG

MARSHALL
J 114
9/30/74

Sept 30 1974 date well completed
Earl Jones Well Co. firm name
Marshall county well located

LANDOWNER:
Woodrow Conway
Victoria miss
(mailing address)

WELL LOCATION:
sec 3 T 3 N R 4 E
1/6 miles S of Victoria
(distance) (direction) (nearest town)

description of formations encountered	from	to
Topsoil & clay	0	14
clay	0	40
clay	40	50
clay	50	70
clay	70	90
sand	90	154

WELL PURPOSE: Home
(home, irrigation, municipal, industrial)

WELL COMPLETION DATA:

(1) diameter (inches) 4"

(2) total depth (feet) 154

(3) static water level (feet) 70 below top of ground.

(4) casing plastic 148
(material) (depth)
4" if telescope see back.
(size)

(5) screen 15' 148
(length) (depth to top)
4" plastic gravel
(size) (material)

(6) pump 1/2 1.6
(HP) (yield gpm)
Electric
(type power)

(7) electric log no
(yes or no)

CODED

(organization running log)

(8) how well bottom plugged
plastic cap


DRILLERS REMARKS:

RECEIVED
OCT 17 1974

MISS. RD. OF WATER COMMISSIONERS

If well telescopes please sketch and show depths.

GROUND LEVEL

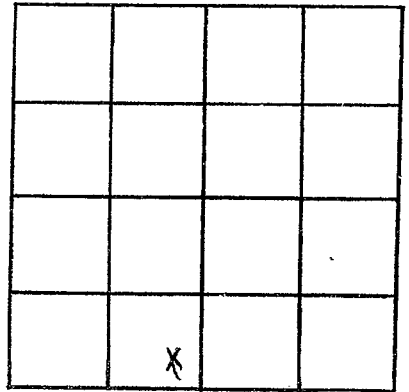

SECTION 3

Please indicate well location X.

ADDITIONAL INFORMATION

If more than one screen,
show locations of each on sketch.