

MARSHALL

J115

9/17/74

MISSISSIPPI
 BOARD OF WATER COMMISSIONERS
 416 North State Street
 Jackson, Mississippi 39201

CODED

WATER WELL DRILLERS LOG

Sept 17

1974 Earl Jones Well Co.

firm name

Marshall

county well located

LANDOWNER:

Robert Dixon

Byhalia miss. Rt.
(mailing address)

WELL LOCATION:

sec. 32 T 3 N R 4 E
 3 S W
 3 miles (distance) (direction) of (nearest town) Victoria

WELL PURPOSE:

Home (home, irrigation, municipal, industrial)

WELL COMPLETION DATA:

- (1) diameter (inches) 4"
- (2) total depth (feet) 92'
- (3) static water level (feet) 65' below above top of ground.
- (4) casing plastic (material), 86 (depth), 4" (size) if telescope see back.
- (5) screen 6' (length), 86 (depth to top), 4" (size), plastic gravel (material)
- (6) pump 1/2 (HP), 12 (yield gpm), electric (type power)
- (7) electric log no (yes or no)

(organization running log)

(8) how well bottom plugged plastic cap.

description of formations encountered


from

to

Topsail + clay
 sand
 clay
 sand
 clay
 sand

0	12
12	20
20	26
26	40
40	48
48	92

CODED

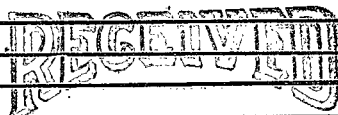


OCT 17 1974

DRILLERS REMARKS:

If well telescopes please sketch and show depths.

GROUND LEVEL

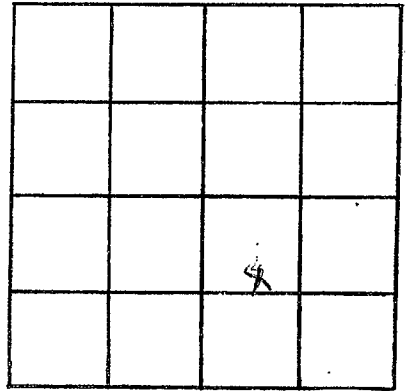

SECTION 32

Please indicate well location X.

ADDITIONAL INFORMATION

If more than one screen,
show locations of each on sketch.