

MARSHALL
 JIK
 9-7-74

MISSISSIPPI
 BOARD OF WATER COMMISSIONERS
 416 North State Street
 Jackson, Mississippi 39201

CODED

WATER WELL DRILLERS LOG

9-7-74 date well completed
 W.G. Mason firm name
 Marshall county well located

LANDOWNER:	description of formations encountered	from	to
Simpson Taylor	Clay Just	90	10
Victoria Mesa. (mailing address)	Red sand	10	80
	white sand	80	150

LANDOWNER:

description of formations encountered

from

to

WELL LOCATION:

sec. 9 T 3 N R 4 E
 S W
 1/4 miles West of Victoria
 (distance) (direction) (nearest town)

WELL PURPOSE: Home
 (home, irrigation, municipal, industrial)

WELL COMPLETION DATA:


- (1) diameter (inches) 4"
- (2) total depth (feet) 150'
- (3) static water level (feet) 80' below top of ground.
- (4) casing Plastic, 140'
 (material) (depth)
- 4" if telescope see back.
 (size)
- (5) screen 10' 140'
 (length) (depth to top)
- 4" Plastic
 (size) (material)
- (6) pump 1 15
 (HP) (yield gpm)
- electric
 (type power)
- (7) electric log No
 (yes or no)

(organization running log)

(8) how well bottom plugged Cap

DRILLERS REMARKS:

CODED

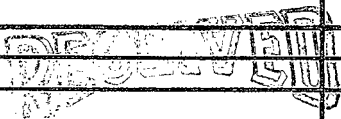


DEC 27 1974

MISS. RD. OF WATER COMMISSIONERS

If well telescopes please sketch and show depths.

GROUND LEVEL

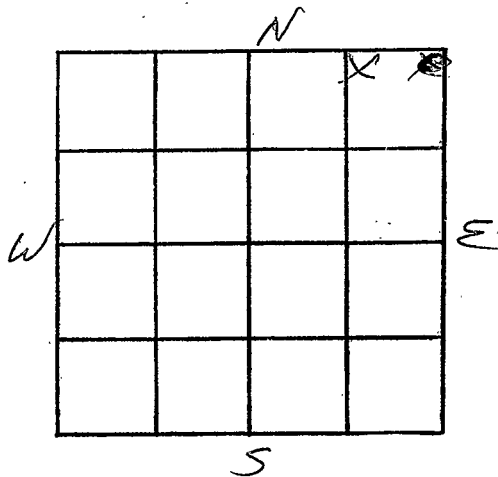

SECTION 9

Please indicate well location X.

ADDITIONAL INFORMATION

If more than one screen, show locations of each on sketch.