

MARSHALL
J 119
7-13-74

MISSISSIPPI
 BOARD OF WATER COMMISSIONERS
 416 North State Street
 Jackson, Mississippi 39201

CODED

WATER WELL DRILLERS LOG

7-13-1974 date well completed
 W.C. Mason firm name
 Marshall county well located

LANDOWNER:	description of formations encountered	from	to
McKissack Richmond			
RFD, Holly Springs Miss (mailing address)	Red sand	12	40
WELL LOCATION:	pebbles sand	40	110
sec. 35 T 3 N R 4 (S) (W)	Blue clay	110	135
7 miles west of Holly Springs (distance) (direction) (nearest town)	pebbles sand	135	195
WELL PURPOSE: Home (home, irrigation, municipal, industrial)			
WELL COMPLETION DATA:			
(1) diameter (inches) 4"			
(2) total depth (feet) 195'			
(3) static water level (feet) 88' below top of ground.			
(4) casing Plastic, 195' (material) (depth)			
4" if telescope see back. (size)			
(5) screen 10' 185' (length) (depth to top)			
4" Plastic (size) (material)			
(6) pump 3/4 12 (HP) (yield gpm)			
electric (type power)			
(7) electric log No (yes or no)			
(organization running log)			
(8) how well bottom plugged cap			
DRILLERS REMARKS:			


CODED

MISS. DEPT. OF WATER RESOURCES
 DEPT. OF WATER RESOURCES
 DEPT 1374

MISS. DD. OF WATER COMMISSIONERS

If well telescopes please sketch and show depths.

GROUND LEVEL

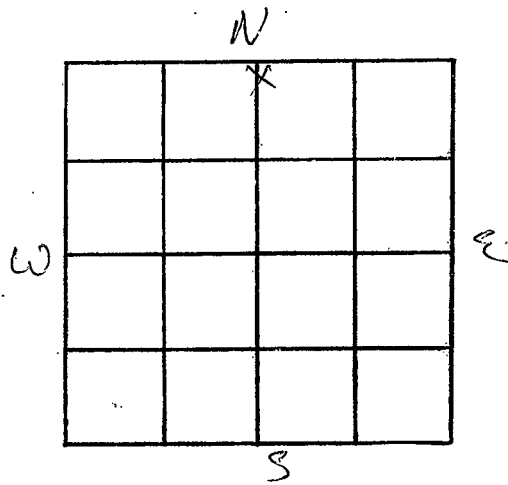

Please indicate well location X.

ADDITIONAL INFORMATION

If more than one screen, show locations of each on sketch.