

MARSHALL
 J 120
 6-13-74

MISSISSIPPI
 BOARD OF WATER COMMISSIONERS
 416 North State Street
 Jackson, Mississippi 39201

CODED

WATER WELL DRILLERS LOG

6-13-74
 date well completed

W.O. Mason
 firm name

Marshall
 county well located

LANDOWNER:

Calvin Earl Wilson
 Rt. 1, Byhalia, Miss.
 (mailing address)

description of formations encountered

from

to

clay	10	15
red clay	15	17
Hard Rock	17	19
white clay	19	40
Rock	40	41

WELL LOCATION:

sec. 4 T 3 N R 4 E
 3 1/2 miles SE of Byhalia
 (distance) (direction) (nearest town)

WELL PURPOSE: Home
 (home, irrigation, municipal, industrial)

WELL COMPLETION DATA:

- (1) diameter (inches) 4"
- (2) total depth (feet) 153'
- (3) static water level (feet) 100' below top of ground.
- (4) casing Plastic, 135'
 (material) (depth)
4" If telescope see back.
 (size)
- (5) screen 18', 135'
 (length) (depth to top)
14", Plastic
 (size) (material)
- (6) pump 1/2, 7
 (HP) (yield gpm)
electric
 (type power)
- (7) electric log No
 (yes or no)

Blue clay, ~~cap~~ 100
 white sand 100 153

(organization running log)

(8) how well bottom plugged cap

RECEIVED
 MISSISSIPPI


DEC 27 1974

MISS. BD. OF WATER COMMISSIONERS

DRILLERS REMARKS:

If well telescopes please sketch and show depths.

GROUND LEVEL

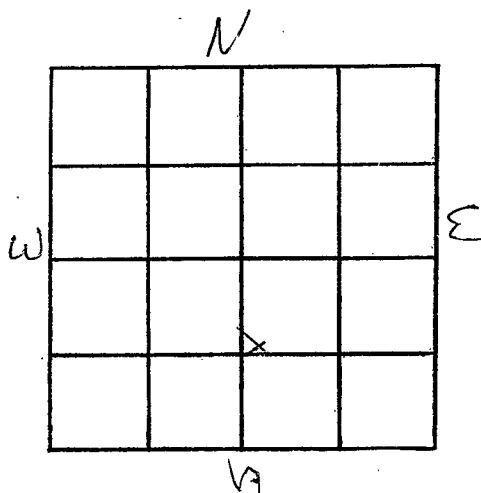

SECTION 4

Please indicate well location X.

ADDITIONAL INFORMATION

If more than one screen, show locations of each on sketch.