

MARSHALL
 J 121
 5-17-74

MISSISSIPPI
 BOARD OF WATER COMMISSIONERS
 416 North State Street
 Jackson, Mississippi 39201

CODED

WATER WELL DRILLERS LOG

5-17-1974 date well completed W.G. Mason firm name Marshall county well located

LANDOWNER:
 Robert Shalaco Jr.
 Rt. Byhalia Miss.
 (mailing address)

description of formations encountered	from	to
clay silt	10	15
Red clay	15	60
white clay	60	80
white sand	80	130

WELL LOCATION:
 sec. 7 T. 3 N. R. 4 E.
 2 1/2 miles SE of Byhalia
 (distance) (direction) (nearest town)

WELL PURPOSE: Home
 (home, irrigation, municipal, industrial)

- WELL COMPLETION DATA:
- (1) diameter (inches) 4
 - (2) total depth (feet) 130'
 - (3) static water level (feet) 65' below top of ground.
 - (4) casing Plastic, 120'
 (material) (depth)
 4" If telescope see back.
 (size)
 - (5) screen 10' 120'
 (length) (depth to top)
 4" Plastic
 (size) (material)
 - (6) pump 1/2 7
 (HP) (yield gpm)
 electric
 (type power)
 - (7) electric log No
 (yes or no)
- (organization running log)
- (8) how well bottom plugged Cap


RECEIVED
 DEC 27 1974

DRILLERS REMARKS:

MISS. BD. OF WATER COMM.

If well telescopes please sketch and show depths.

GROUND LEVEL

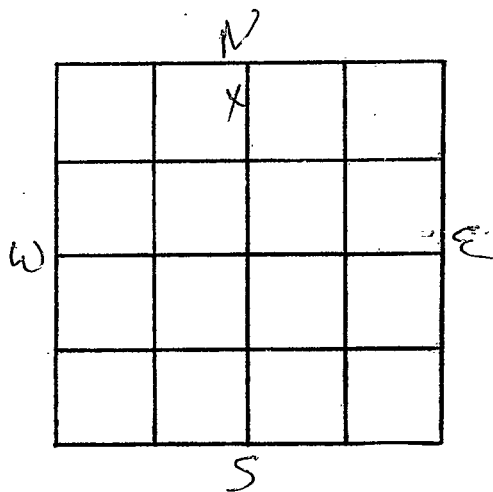

SECTION 7

Please indicate well location X.

ADDITIONAL INFORMATION

If more than one screen, show locations of each on sketch.