


MARSHALL
J122
6-4-74

MISSISSIPPI
 BOARD OF WATER COMMISSIONERS CODED
 416 North State Street
 Jackson, Mississippi 39201

WATER WELL DRILLERS LOG

6-4- 19 74 W.C. Mason Marshall
 date well completed firm name county well located

LANDOWNER:	description of formations encountered	from	to
John W. Claunch Red Banks Miss. (mailing address)			
	red sand	12	42
	white clay	42	150
WELL LOCATION:			
sec. <u>12</u> T <u>3</u> N R <u>4</u> E <u>1/2</u> miles <u>S</u> west of <u>Red Banks</u> (distance) (direction) (nearest town)			
WELL PURPOSE: <u>Home</u> (home, irrigation, municipal, industrial)			
WELL COMPLETION DATA:			
(1) diameter (inches) <u>4"</u>			
(2) total depth (feet) <u>152'</u>			
(3) static water level (feet) <u>92'</u> below top of ground.			
(4) casing <u>Plastic</u> , <u>140'</u> (material) (depth)			
<u>4"</u> (size) if telescope see back.			
(5) screen <u>10'</u> , <u>140'</u> (length) (depth to top)			
<u>4"</u> , <u>Plastic</u> (size) (material)			
(6) pump <u>1/2</u> , <u>7</u> (HP) (yield gpm)			
<u>electric</u> (type power)			
(7) electric log <u>NE</u> (yes or no)			
(organization running log)			
(8) how well bottom plugged <u>Cap</u>			
DRILLERS REMARKS:			

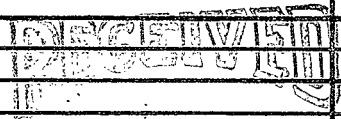


DEC 27 1974

MISS. BD. OF WATER COMM

If well telescopes please sketch and show depths.

GROUND LEVEL

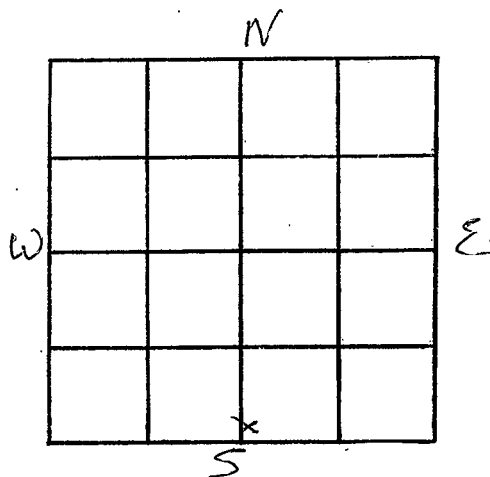

SECTION 12

Please indicate well location X.

ADDITIONAL INFORMATION

If more than one screen, show locations of each on sketch.