

MARSHALL  
~~H 80~~ J 123  
 1-23-74

MISSISSIPPI  
 BOARD OF WATER COMMISSIONERS  
 416 North State Street JACKSON, MISSISSIPPI 39201  
 CODED

WATER WELL DRILLERS LOG

1-23-1974 W.R. Mason Marshall  
 date well completed: firm name county well located

LANDOWNER:	description of formations encountered	from	to
Walter Houston	clay loess	70	10
Rt. 1, Byhalia Miss. (mailing address)	Red sand	10	80
WELL LOCATION:	white sand	80	100
sec. 30 T 3 N R 5 E 1 1/8 miles East of Watson (distance) (direction) (nearest town)			
WELL PURPOSE: Home (home, irrigation, municipal, industrial)			
WELL COMPLETION DATA:			
(1) diameter (inches) 4			
(2) total depth (feet) 100'			
(3) static water level (feet) 70 below top of ground.			
(4) casing Plaster 90' (material) (depth)			
4" If telescope see back. (size)			
(5) screen 10' 90' (length) (depth to top)			
4" Plaster (size) (material)			
(6) pump 1/3 10 (HP) (yield gpm)			
electric (type power)			
(7) electric log No. (yes or no)			
(organization running log)			
(8) how well bottom plugged cap			
DRILLERS REMARKS:			


CODED

RECEIVED  
 MISSISSIPPI  
 DEC 27 1974

MISS. BD. OF WATER COMM

If well telescopes please sketch and show depths.

GROUND LEVEL

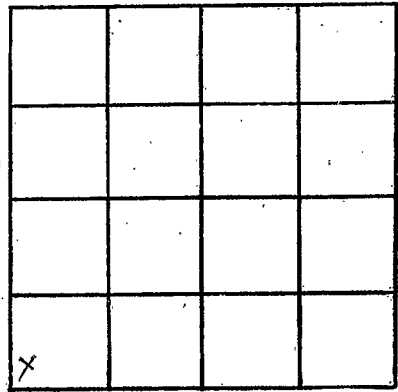

SECTION 30

Please indicate well location X.

ADDITIONAL INFORMATION

If more than one screen, show locations of each on sketch.