

MARSHALL

J124

12-20-74

MISSISSIPPI BOARD OF WATER COMMISSIONERS  
416 North State Street  
Jackson, Mississippi 39201

CODED

WATER WELL DRILLERS LOG

Dec 20 19 74  
date well completed

Earl Jones well co  
firm name

Marshall  
county well located

LANDOWNER:

J. J. Franks

description of formations encountered

from

to

Holly Springs Miss. Rt.  
(mailing address)

Top soil + clay  
rock  
clay  
sand  
clay  
sand

0 16  
16 17  
17 25  
25 70  
70 96  
96 142

WELL LOCATION:


sec 23 T 3 N R 4 E  
S W  
2 miles S.W. of Red Bank  
(distance) (direction) (nearest town)

WELL PURPOSE: Home  
(home, irrigation, municipal, industrial)

WELL COMPLETION DATA:

- (1) diameter (inches) 4"
- (2) total depth (feet) 142
- (3) static water level (feet) 100 below top of ground.
- (4) casing plastic 136 (material), (depth)  
4" (size) If telescope see back.
- (5) screen 6" 136 (length), (depth to top)  
4" plastic gravel (size), (material)
- (6) pump 1/2 15 (HP), (yield gpm)  
electric (type power)
- (7) electric log no (yes or no)

CODED

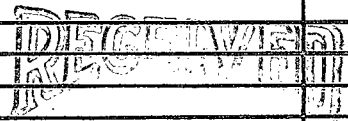

JAN 24 1975

WATER COMM

(organization running log)

(8) how well bottom plugged  
plastic cap

DRILLERS REMARKS:

If well telescopes please sketch and show depths.

GROUND LEVEL

			+

SECTION 23

Please indicate well location X.

ADDITIONAL INFORMATION

If more than one screen,  
show locations of each on sketch.