

MARSHALL
~~#74~~ J 128
 4-8-74

MISSISSIPPI
 BOARD OF WATER COMMISSIONERS
 416 North State Street
 Jackson, Mississippi 39201

WATER WELL DRILLERS LOG

4-8-74 1974 W. R. Mason Marshall
 date well completed firm name county well located

LANDOWNER:
 Jeff Mills
 Memphis Tenn.
 (mailing address)

description of formations encountered	from	to
clay silt	40	18
Red sand	18	60
white sand	60	100
hard rock	at	100

WELL LOCATION:
 sec. 8 T. 3 N. R. 4 E.
 1 3/4 miles West of VICTORIA
 (distance) (direction) (nearest town)

WELL PURPOSE: Home
 (home, irrigation, municipal, industrial)


- WELL COMPLETION DATA:
- (1) diameter (inches) 4
 - (2) total depth (feet) 100
 - (3) static water level (feet) 60 below top of ground.
 - (4) casing (material) (depth) 90'
 4" if telescope see back.
 (size)
 - (5) screen (length) (depth to top) 10' - 90'
 4" (size) (material) Plastic
 - (6) pump (HP) (yield gpm) 1/2 5
 electric (type power)
 - (7) electric log No (yes or no)
- (organization running log)
- (8) how well bottom plugged cap

RECEIVED
 MISSISSIPPI
 DEC 27 1974

DRILLERS REMARKS:

If well telescopes please sketch and show depths.

GROUND LEVEL

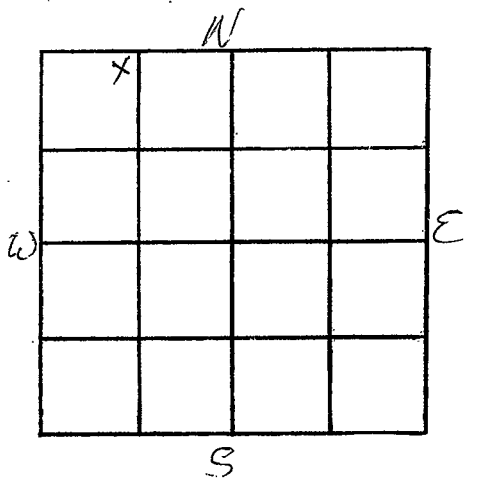

SECTION 8

Please indicate well location X.

ADDITIONAL INFORMATION

If more than one screen, show locations of each on sketch.