

MARSHALL

~~H-77~~ J 129

3-20-74

MISSISSIPPI  
BOARD OF WATER COMMISSIONERS  
416 North State Street  
Jackson, Mississippi 39201

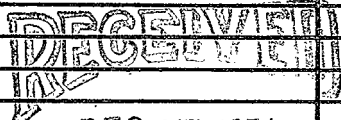
CODED

WATER WELL DRILLERS LOG

3-20-74  
date well completed

W.A. Mason  
firm name

Marshall  
county well located

LANDOWNER:	description of formations encountered	from	to
Robert D. Black	clay dust	80	10
R. 2, Byhalia Miss. (mailing address)	red sand	10	40
WELL LOCATION:	white sand	40	93
sec. 8 T. 3 N. R. 4 E. S. 5 W. 1 3/4 miles west of Victoria (distance) (direction) (nearest town)	hard rock	93	
WELL PURPOSE: home (home, irrigation, municipal, industrial)	CODED		
WELL COMPLETION DATA:			
(1) diameter (inches) 4"			
(2) total depth (feet) 93'			
(3) static water level (feet) 63' below top of ground.			
(4) casing Plastic 83' (material) (depth) 4" (size) If telescope see back.			
(5) screen 10' 83' (length) (depth to top) 4" Plastic (size) (material)			
(6) pump 1/3 5 (HP) (yield gpm) electric (type power)			
(7) electric log yes (yes or no)			
(8) how well bottom plugged cap (organization running log)			
DRILLERS REMARKS:	 DEC 27 1974 MISS. BD. OF WATER COMM		

