

MARSHALL

J 131

3-1-75

MISSISSIPPI
 BOARD OF WATER COMMISSIONERS
 416 North State Street
 Jackson, Mississippi 39201

WATER WELL DRILLERS LOG

March 1, 1975 - Earl Jones Well Co. Marshall
 date well completed: firm name: county well located:


LANDOWNER: William Watkins
Byhalia miss.
AT-
 (mailing address):

description of formations encountered	from	to
<u>clay</u>	<u>0</u>	<u>18</u>
<u>sand</u>	<u>18</u>	<u>89</u>

WELL LOCATION:
 sec 35 T. 3 N. R. 4 E.
5 miles SE of Victoria
 (distance) (direction) (nearest town)

WELL PURPOSE: Home
 (home, irrigation, municipal, industrial)

- WELL COMPLETION DATA:
- (1) diameter (inches): 4"
 - (2) total depth (feet): 89
 - (3) static water level (feet): 54' below top of ground. above
 - (4) casing: plastic 83
 (material): (depth)
4"
 (size) if telescope see back.
 - (5) screen: 6' 82
 (length): (depth to top)
4" plastic gravel
 (size) (material)
 - (6) pump: 1/2 16
 (HP) (yield gpm)
Electric
 (type power)
 - (7) electric log no
 (yes or no)
- (organization running log)

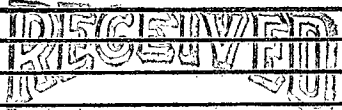


MAR 01 1975

MISS. BD. OF WATER COMM

(8) how well bottom plugged:
plastic cap
 DRILLERS REMARKS:

If well telescopes please
sketch and show depths.

GROUND LEVEL

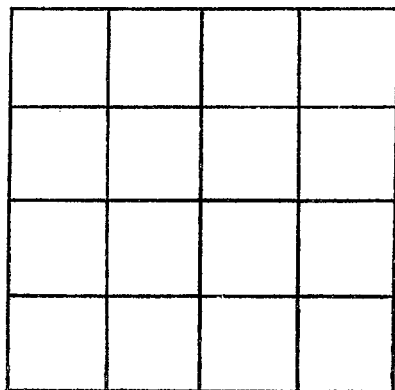

SECTION _____

Please indicate well location X.

ADDITIONAL INFORMATION

If more than one screen,
show locations of each on sketch.