

Marshall
 J 132
 5-14-75

MISSISSIPPI
 BOARD OF WATER COMMISSIONERS
 416 North State Street
 Jackson, Mississippi 39201

CODED

WATER WELL DRILLERS LOG

May 14 1975 Earl Jones Well Co Marshall
 date well completed firm name county well located

| LANDOWNER: | description of formations encountered | from | to |
|---------------------------------------|---------------------------------------|------|-----|
| Earl h abston | | | |
| Byhalia miss RT. (mailing address) | Topsoil & clay sand | 0 | 18 |
| | clay | 18 | 110 |
| | rock | 110 | 116 |
| | clay | 116 | 118 |
| | sand | 118 | 165 |
| | | 165 | 181 |

WELL LOCATION:
 sec 24 T 43 N R 4 E 15E
 4 miles S of Victoria
 (distance) (direction) (nearest town)

WELL PURPOSE: Home
 (home, irrigation, municipal, industrial)


- WELL COMPLETION DATA:
- (1) diameter (inches) 4"
 - (2) total depth (feet) 181
 - (3) static water level (feet) 110 below above top of ground.
 - (4) casing Plastic 175 (material) (depth)
4" (size) if telescope see back.
 - (5) screen 6' 175 (length) (depth to top)
4" plastic gravel (size) (material)
 - (6) pump 1/2 19 (HP) (yield gpm)
electric (type power)
 - (7) electric log no - (yes or no)
(organization running log)
 - (8) how well bottom plugged plastic cap

DRILLERS REMARKS:

REGISTERED
 JUN 21 1975
 MISS. BD. OF WATER COMMISSIONERS

If well telescopes please sketch and show depths.

GROUND LEVEL

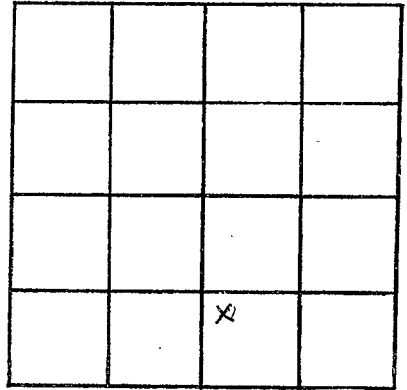

SECTION 24

Please indicate well location X.

ADDITIONAL INFORMATION

If more than one screen,
show locations of each on sketch.