

Marshall  
 J 133  
 5-24-75

MISSISSIPPI  
 BOARD OF WATER COMMISSIONERS  
 416 North State Street  
 Jackson, Mississippi 39201

CODED

WATER WELL DRILLERS LOG

5-24-1975 date well completed  
 W. E. Mason Water Well Contractors firm name  
 Marshall county well located

LANDOWNER:

Mary R. Wooten  
 Rt. 1 Byhalia Miss.  
 (mailing address)

description of formations encountered

from to

Clay dirt	10	20
red sand	20	62
Rock	62	64
yellow sand	64	135

WELL LOCATION:

sec. 5 T. 3 N. R. 4 E.  
 2 1/2 miles S of Byhalia  
 (distance) (direction) (nearest town)

WELL PURPOSE: Home  
 (home, irrigation, municipal, industrial)

CODED


WELL COMPLETION DATA:

- (1) diameter (inches) 4"
- (2) total depth (feet) 135'
- (3) static water level (feet) 98' below top of ground.
- (4) casing (material) Plaster, (depth) 115'
- (size) 4" if telescope see back.
- (5) screen (length) 20', (depth to top) 115'
- (size) 4" (material) Plaster
- (6) pump (HP) 1/2 (yield gpm) 5
- (type power) electric
- (7) electric log No (yes or no)

(organization running log)

(8) how well bottom plugged  
 Capson Seal


DRILLERS REMARKS:

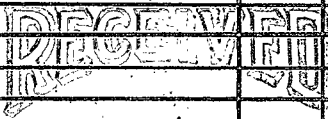

JUL 01 1975

If well telescopes please sketch and show depths.

GROUND LEVEL

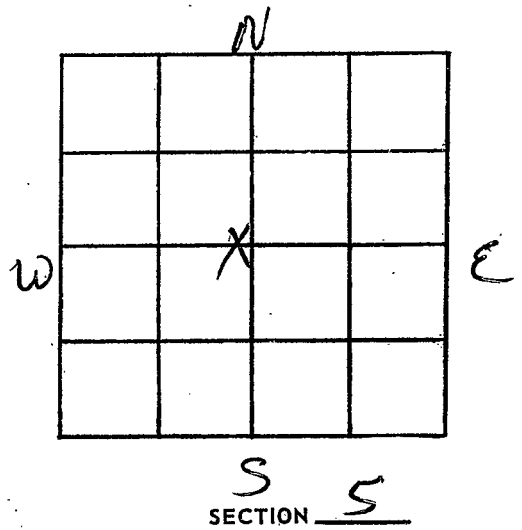

Please indicate well location X.

ADDITIONAL INFORMATION

If more than one screen, show locations of each on sketch.