

Marshall  
 J 134  
 6-18-75

MISSISSIPPI  
 BOARD OF WATER COMMISSIONERS  
 416 North State Street  
 Jackson, Mississippi 39201

WATER WELL DRILLERS LOG

June 18 1975 Earl Jones Well Co. Marshall  
 Date well completed firm name county well located


LANDOWNER:  
 Victoria Postoffice  
 Victoria miss  
 (mailing address)  
 WELL LOCATION:  
 sec 10 T 3 R 4 E 1SE  
 2 miles S of Victoria  
 (distance) (direction) (nearest town)

description of formations encountered	from	to
Topsoil + clay	0	20
sand	20	32
clay	32	38
sand	38	80
clay	80	90
sand	90	125
clay	125	130
sand	130	147

WELL PURPOSE: Post office  
 (home, irrigation, municipal, industrial)

WELL COMPLETION DATA:  
 (1) diameter (inches): 4"  
 (2) total depth (feet): 147  
 (3) static water level (feet): 80 below top of ground.  
 (4) casing: plastic 127 (material) (depth)  
 4" (size) If telescope see back.  
 (5) screen: 20' 127 (length) (depth to top)  
 4" (size) plastic (material)  
 (6) pump: 3/4 20 (HP) (yield gpm)  
 Electric (type power)  
 (7) electric log No (yes or no)  
 (organization running log)  
 (8) how well bottom plugged: plastic cap


DRILLERS REMARKS:

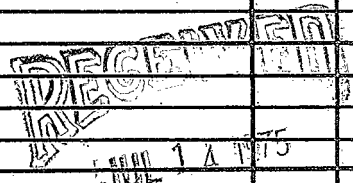

MISS. BD. OF WATER COMMISSIONERS

If well telescopes please sketch and show depths.

GROUND LEVEL

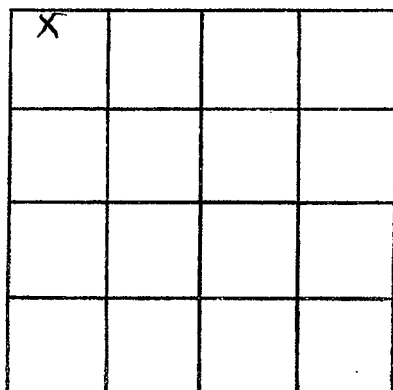

SECTION 10

Please indicate well location X.

ADDITIONAL INFORMATION

If more than one screen, show locations of each on sketch.