

Marshall
 J 135
 6-21-75

MISSISSIPPI
 BOARD OF WATER COMMISSIONERS
 416 North State Street
 Jackson, Mississippi 39201

CODED

WATER WELL DRILLERS LOG

June 21 1975 date well completed
 Earl Jones Well Co. firm name
 Marshall county well located

LANDOWNER:
 Calvin Cowan
 Holly Springs Miss Rt.
 (mailing address)

WELL LOCATION:
 sec 36 T 3 N R 4 E 15E
 4 miles S of Red Banks
 (distance) (direction) (nearest town)

description of formations encountered	from	to
Topsail & clay	0	19
sand	19	70
clay	70	92
sand	92	130
clay	130	138
sand	138	160

WELL PURPOSE: Home
 (home, irrigation, municipal, industrial)

WELL COMPLETION DATA:

(1) diameter (inches) 4"

(2) total depth (feet) 160

(3) static water level (feet) 120 below top of ground.

(4) casing plastic 154' (material) (depth)
 4" (size) if telescope see back.

(5) screen 6' 154' (length) (depth to top)
 4" plastic gravel (size) (material)

(6) pump 1/2 15 (HP) (yield gpm)
 Electric (type power)

(7) electric log No (yes or no)

(organization running log)

(8) how well bottom plugged plastic cap

CODED


RECEIVED
 JUL 14 1975
 MISS. BU. OF WATER COM.

DRILLERS REMARKS:

MISS. BU. OF WATER COM.

If well telescopes please sketch and show depths.

GROUND LEVEL

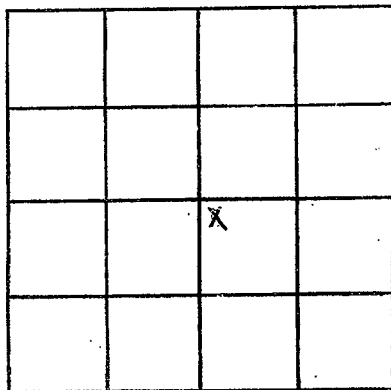

SECTION 36

Please indicate well location X.

ADDITIONAL INFORMATION

If more than one screen,
show locations of each on sketch.