

Marshall
 J 136
 8-20-75

MISSISSIPPI
 BOARD OF WATER COMMISSIONERS
 416 North State Street
 Jackson, Mississippi 39201

CODED

WATER WELL DRILLERS LOG

Aug 20 1975 Earl Jones Well Co. Marshall
 date well completed firm name county well located

LANDOWNER:
 Hattie Cummings
 Byhalia Miss. Rt.
 (mailing address)

| description of formations encountered | from | to |
|---------------------------------------|-----------------|-----|
| | Topsail or clay | 0 |
| sand | 16 | 22 |
| clay | 22 | 45 |
| sand | 45 | 55 |
| clay | 55 | 82 |
| sand | 82 | 142 |

WELL LOCATION:
 sec. 5 T. 3 N. R. 4 E. 15E
 1/8 miles W of Victoria
 (distance) (direction) (nearest town)

WELL PURPOSE: Home
 (home, irrigation, municipal, industrial)

WELL COMPLETION DATA:

(1) diameter (inches) 2

(2) total depth (feet) 142

(3) static water level (feet) 78 below top of ground.

(4) casing plastic 132 (material) (depth)
 2" (size) if telescope see back.

(5) screen 10' 132 (length) (depth to top)
 0.30 inch 2" (size) plastic (material)

(6) pump 1 7 1/2 (HP) (yield gpm)
 Electric (type power)

(7) electric log no. (yes or no)
 (organization running log)


(8) how well bottom plugged plastic cap

DECEMBER 1975
 SEP - 8 1975
 MISS. DD. OF WATER COMMISSIONERS

DRILLERS REMARKS:

If well telescopes please sketch and show depths.

GROUND LEVEL

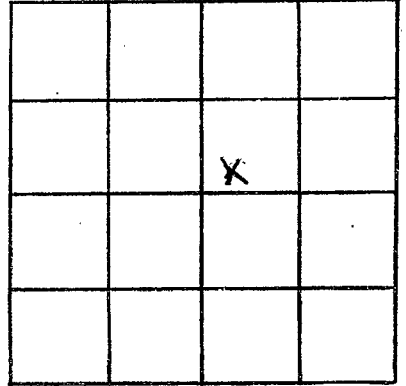

SECTION 5

Please indicate well location X.

ADDITIONAL INFORMATION

If more than one screen,
show locations of each on sketch.