

Marshall
 J 137
 8-9-75

MISSISSIPPI
 BOARD OF WATER COMMISSIONERS
 416 North State Street
 Jackson, Mississippi 39201

CODED

WATER WELL DRILLERS LOG

Aug 9 1975 Earl Jones Well Co. Marshall
 date well completed firm name county well located

LANDOWNER:
Ruben Gay
Holly Springs Miss. Rd.
 (mailing address)

WELL LOCATION:
 sec 4 T 3 N R 4 E 15E
2 1/2 miles S W. of Red Bonds
 (distance) (direction) (nearest town)

description of formations encountered	from	to
<u>Top soil + clay</u>	<u>0</u>	<u>20</u>
<u>sand</u>	<u>20</u>	<u>65</u>
<u>clay</u>	<u>65</u>	<u>70</u>
<u>sand</u>	<u>70</u>	<u>90</u>
<u>clay</u>	<u>90</u>	<u>98</u>
<u>sand</u>	<u>98</u>	<u>142</u>

WELL PURPOSE: Home
 (home, irrigation, municipal, industrial)

WELL COMPLETION DATA:

(1) diameter (inches) 4"

(2) total depth (feet) 142

(3) static water level (feet) 100 below top of ground.

(4) casing plastic 132
 (material) (depth)
4" if telescope see back.
 (size)


(5) screen 10' 132
 (length) (depth to top)
4" (size) plastic (material)

(6) pump 1/2 15
 (HP) (yield gpm)
Electric
 (type power)

(7) electric log no
 (yes or no)
 (organization running log)

(8) how well bottom plugged
plastic cap

CODED

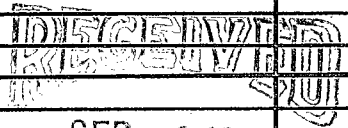

SEP - 6 1975

DRILLERS REMARKS:

If well telescopes please sketch and show depths.

GROUND LEVEL

	X		

SECTION 14

Please indicate well location X.

ADDITIONAL INFORMATION

If more than one screen,
show locations of each on sketch.