

MISSISSIPPI DEPARTMENT OF NATURAL RESOURCES

Bureau of Land and Water Resources

Southport Mall

P.O. Box 10631

CODED

Jackson, Mississippi 39209

WATER WELL DRILLERS LOG

J-138
MARSHALL
7-14-

7-14 1980 date well completed
Rich W. Allen firm name
Marshall county well located

LANDOWNER:
Drene Caldwell
(mailing address)

description of formations encountered	from	to
Clay	0	30
red sand	30	120
white sand	120	200
CODED		

WELL LOCATION:
sec 30 T 3 N R 4 E
Lee Crossing
miles of (distance) (direction) (nearest town)

WELL PURPOSE: Home
(home, irrigation, municipal, industrial)


WELL COMPLETION DATA:
(1) diameter (inches) 4 in
(2) total depth (feet) 200
(3) static water level (feet) 180 below top of ground.
(4) casing Plastic 200 (material) (depth)
(size) If telescope see back.
(5) screen 7 ft 193 (length) (depth to top)
4 in (size) gravel (material)
(6) pump 1/2 10 (HP) (yield gpm)
220 (type power)
(7) electric log No (yes or no)
(organization running log)

(8) how well bottom plugged Cap

DRILLERS REMARKS:

DEPT. OF NATURAL RESOURCES
BUREAU OF LAND & WATER RESOURCES
SEP 4 - 1980
RECEIVED

If well telescopes please sketch and show depths.

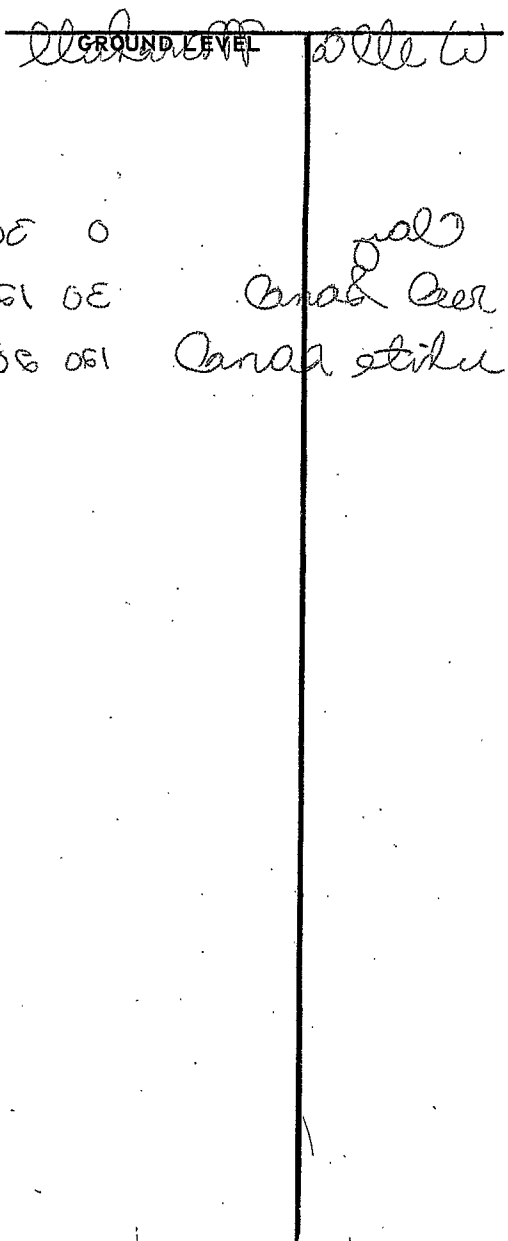

		X		FT
Double ended				
0	4		5	08
Pipes 2' each				

embed SECTION 30

Please indicate well location X.

ADDITIONAL INFORMATION

m
 008
 081
 008 11/10/9
 EPI 4/11
 sand w/ N
 01 11
 088
 11
 900

If more than one screen, show locations of each on sketch.