

MARSHALL  
 J139  
 3/22/83

MISSISSIPPI DEPARTMENT OF NATURAL RESOURCES  
 Bureau of Land and Water Resources  
 Southport Mall  
 P.O. Box 10631  
 Jackson, Mississippi 39209  
 WATER WELL DRILLERS LOG

CODED

3/22 19 83 Layne-Central Company Marshall  
 date well completed firm name county well located

LANDOWNER:	description of formations encountered	from	to
Victoria Baby Farms Water Association	Clay	0	18
Victoria, Mississippi	Coarse Sand	18	139
(mailing address)	Clay stks. & Sand	139	160
WELL LOCATION:	Coarse Sand	160	195
sec. 9 T. 3 N. R. 4 E S W	White Clay	195	200
1 miles SW of Victoria			
(distance) (direction) (nearest town)			
WELL PURPOSE: municipal			
(home, irrigation, municipal, industrial)			
WELL COMPLETION DATA:			
(1) diameter (inches) 6"			
(2) total depth (feet) 193'			
(3) static water level (feet) 109' below top of ground.			
(4) casing steel 164' (material) (depth)			
6" (size) if telescope see back.			
(5) screen 31' 191' (length) (depth to top)			
4" stainless steel (size) (material)			
(6) pump 5 40 @ 68 psi (HP) (yield gpm)			
elec. motor (type power)			
(7) electric log no (yes or no)			
(organization running log)			
(8) how well bottom plugged cement			

CODED

DEPT. OF NATURAL RESOURCES  
 BUREAU OF LAND & WATER RESOURCES

MAR 25 1983


RECEIVED

DRILLERS REMARKS:



If well telescopes please sketch and show depths.

GROUND LEVEL

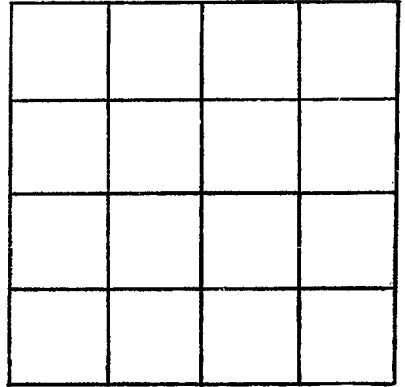

SECTION \_\_\_\_\_

Please indicate well location X.

ADDITIONAL INFORMATION

If more than one screen,  
show locations of each on sketch.