




If well telescopes please  
sketch and show depths.

GROUND LEVEL

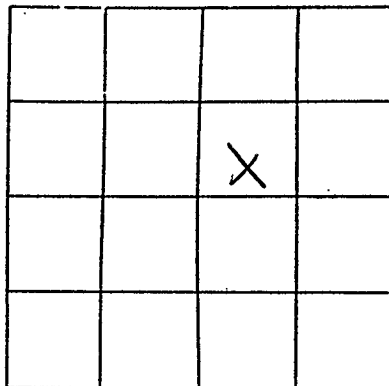

SECTION 9

Please indicate well location X.

Pump Capacity (GPM)	No. of Stages	Setting Depth
12	11	140 FT.

PUMP TEST

Well yielded \_\_\_\_\_ GPM with  
a drawdown of \_\_\_\_\_ ft.  
after \_\_\_\_\_ hours of pumping

LOG DATA

TYPE OF LOG RUN (Circle One): \_\_\_\_\_ No Log Run,  
Electric, Gamma Ray, Density, Sonic, Neutron,  
Other (Describe) \_\_\_\_\_

Name of Organization Running Log

GEOLOGIC DATA (Office Use Only)

Surface Elev.	Geologic Unit	Unit Thickness	Depth to Top
Subs. SWL	Date	Analysis	Aquifer Test

Driller's Remarks

3/4 hp - wmg bladder

If more than one screen,  
show location of each on sketch.