

093

State Well Report

Part 1

Mississippi Department of Environmental Quality
Office of Land and Water Resources
P.O. Box 10631
Jackson, MS 39289-0631
(601)961-5210
(601)354-6938 (fax)

County: Marshall
 Permit #: _____
 Driller: James W. Mason
 Date drilling completed: 8-24-04

For Office Use Only:
 Aquifer: _____
 Well #: J-189
 L. S. Elevation: _____
 E-log #: _____

State Law requires that this report be prepared by the driller in detail and filed with the Department within 30 days of completion of drilling of the well.

Well Owner Information	Well Location
Owner Name: <u>Jed B Builders</u>	Latitude: <u>34° 49' 21"</u> Longitude: <u>89° 37' 12"</u>
Mailing Address: <u>Lot 3 timberidge</u> <u>timberidge cove</u>	Method of Lat/Long (circle one): Conventional Survey, <u>13</u>
<u>Bethel</u> <u>MS</u> <u>38611</u>	USGS quad, <u>Hand-held GPS</u> , Survey-grade GPS
City State Zip Code	<u>SE</u> 1/4 <u>NE</u> 1/4 Sec. <u>21</u> Twn <u>33</u> Rng <u>4W</u>
Telephone No. <u>(662) 560-8083</u>	<u>SE</u> <u>SE</u> <u>10</u> Distance Direction Nearest Town <u>2 1/2</u> Miles <u>5</u> of <u>Victoria</u>

Well Data

Purpose of Well (circle one) Home Industrial Public Supply Irrigation Fish Culture Other: _____

Date well drilling started: 8-24-04 Date well drilling completed: 8-24-04

If flowing, method of flow regulation: Valve NA Other (describe) _____

Static Water Level: 80' feet above or below (circle one) land surface Date measured: 8-24-04

Method of Measurement (circle one) steel tape electric tape air line other: string and weight

Hole depth: 140' Well depth: 140' Well grouted to a depth of 10 feet

Type of grout (circle one): Cement Bentonite Mix

Casing length: 120' feet Casing diameter: 4 inches Type of casing: pvc

Screen length: 20 feet Screen diameter: 4 inches Type of screen: pvc

Screen slot size: .010 inches Setting depth: From 130 feet to 140 feet

Type of completion (circle all applicable): Gravel packed Underreamed Telescoped Open hole Natural Development

Other (describe): _____

Top of lap pipe or reduction in casing: NA feet. If telescoped or more than one screen, describe on back of page

Logs run (circle all applicable): No log run Electric Gamma Ray Density Sonic Neutron Other: _____

Name of organization running log(s): _____

RECEIVED
SEP 10 2004
BY: OLWR

I certify that the well was drilled, constructed, and completed in accordance with all applicable requirements of the Mississippi Department of Environmental Quality and/or the Mississippi Department of Health regulations and state laws.


James W. Mason 0-620
Print Name of Water Well Contractor and License No.

James W. Mason
Signature of Water Well Contractor

J-189

If well telescopes please sketch below and show depths.

Ground Level

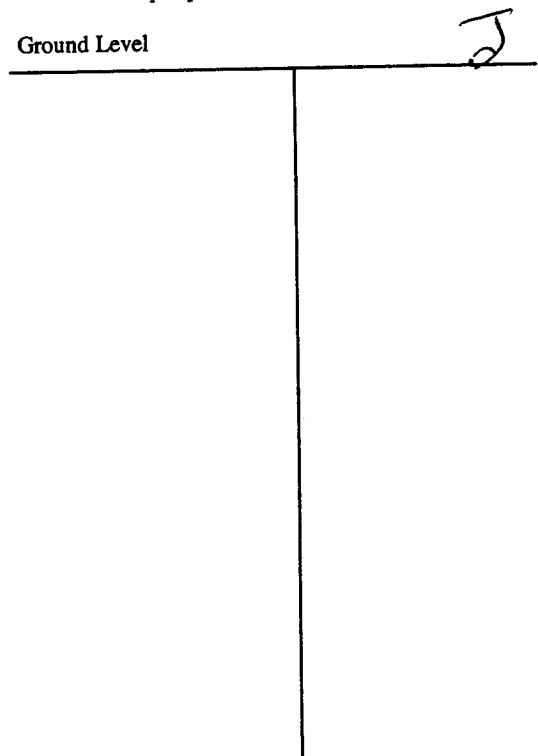

Description of Formations Encountered	From	To
Clay dirt	0	10
red sand	10	25
white sand	25	78
white clay	78	85
white sand	85	135
white clay	135	140

RECEIVED
SEP 10 2004
BY: OLWR

If more than one screen, show location of each on sketch

Sketch the property layout and include the following: 1) the well location; 2) any permanent structures on the property that may aid in locating the well; 3) any roads, power lines, or other items that may aid in locating the property and the well; 4) indicate direction.



Landowner Name: J B Builders. lot 3 timberidge

James W. Mason
Signature of Water Well Contractor

STATE WELL REPORT

Part 2

Pump Installer's Completion Report
 Mississippi Department of Environmental Quality
 Office of Land and Water Resources
 P.O. Box 10631
 Jackson, MS 39289-0631
 (601)961-5210
 (601)354-6938 (fax)

County: Marshall
 Permit #: _____
 Driller: Jones W. Mason
 Date completed: 8-24-04

For Office Use Only:

Aquifer: _____
 Well #: J 189
 Elevation: _____

This report should be prepared by the pump installer in detail and filed with the Department within 30 days of the installation of pump.

Well Owner Information	Well Location
Owner Name: <u>Jord B Builders</u>	Latitude: <u>34.49.212</u> Longitude: <u>089.37.172</u>
Mailing Address: <u>LOT 3 Timberidge sub.</u> <u>Timberidge cove.</u>	Method of Lat/Long (circle one): Conventional Survey, USGS quad, <u>Hand-held GPS</u> , Survey-grade GPS
<u>Byhalia MS 38611</u>	<u>SE 1/4 NE 1/4 Sec 21 Twn 35 Rng 4w</u>
City State Zip Code	Distance Direction Nearest Town
Telephone No. <u>(662) 560-8083</u>	<u>2 1/2</u> Miles <u>S</u> of <u>Victoria</u>

Pump Type Circle one	Power Type Circle one
Air Lift Jet <input type="radio"/> <u>Submersible</u> <input checked="" type="radio"/>	Diesel Engine Gasoline Engine Natural Gas
Bucket Piston <input type="radio"/> Turbine <input type="radio"/>	<u>Electric Motor</u> <input checked="" type="radio"/> Hand <input type="radio"/> Tractor PTO <input type="radio"/>
Centrifugal Rotary <input type="radio"/> Flowing Well <input type="radio"/>	Windmill Other (specify): _____
Other (specify): _____	Horse Power Rating of Motor: <u>3/4</u>
Date Pump Installed: <u>8-24-04</u>	Setting Depth: <u>100</u> feet
Rated Pump Capacity: <u>12</u> Gallons Per Minute	Number of Stages: <u>11</u>

RECEIVED
 SEP 10 2004
 BY: OLWR

Pump Test Data	Method of Measuring Water Level Circle one
Date Well Tested: <u>8-24-04</u>	Air Line Electric Measuring Line Steel Tape
Static Water Level (A): <u>80</u> Feet Below Land Surface	Other (specify): <u>string and weight</u>
Pumping Water Level (B): <u>NA</u> Feet Below Land Surface	For flowing well, measured shut in head: <u>NA</u> feet
Drawdown [(B) - (A)]: <u>NA</u> Feet Below Land Surface	Well yielded <u>12</u> GPM with a drawdown of
Test Pumping Rate: <u>12</u> Gallons Per Minute	<u>NA</u> feet after <u>24</u> hours of pumping
Duration of Pump Test (minimum 4 hours): <u>24</u> hours	

I HEREBY CERTIFY that the above statements are true to the best of my knowledge.

<u>Jones W. Mason</u> Print Name of Pump Installer and License No. (if applicable)	<u>Jones W. Mason</u> Signature of Pump Installer
---	--