	Vell Report For Office Use Only:			
	Driller's Log nt of Environmental Quality Aquifer:			
Permit #: Office of Land				
	and Water Resources Box 10631 Well #: <u>J- 254</u>			
Jackson,	MS 39289-0631 L. S. Elevation:			
)961-5210			
(601)3	E-log #:			
State Law requires that this report be prepared by the li Department at the above address within 30 days of con	cense holder responsible for the work and filed with the upletion of drilling of the well or borehole.			
Information on Well Owner	Well or Borehole Location			
(Landowner if borehole is not for a water well)	Luinda 34 , 49, 287, Laurinda 83, 39, 168,			
Owner Name Jones Robertson	Latitude: 34 . 49 . 287 " Longitude: 89. 39 . 168"			
Owner Name Jones Robertson Mailing Address: 67 St Poul rd.	Method of Lat/Long (circle one): Conventional Survey,			
	USGS quad, (Hand-held GPS, Survey-grade GPS			
Bubalia MS ZEGII	$\frac{NE \frac{1}{4} NE \frac{1}{5} Sec_{1} \frac{1}{5} Twn \frac{3}{5} Rng \frac{1}{4} W}{1}$			
Byholia Ms 38611 City State Zip Code	Distance Direction Nearest Town			
	118 Miles Sw of victoria			
Telephone No. (101) 336 - 9916				
Well / Bo	rehole Data			
Date drilling started: $(6 - 38 - 0)$ Date drilling completed: $(6 - 38 - 0)$ Hole depth: $145'$ Hole diameter: $(63/4)$ Location of the source of any surface water used for drilling:				
Method of dosing and volume of Chlorine used in drilling and development:				
Logs run (circle all applicable). No log run Electric Gamma Ray Density Sonic Neutron Other:				
Purpose of borehole (check one): Water Well \checkmark Geotechnical/Geological Investigation Ground Source Heat Pump				
Seismic SurveyOther (descril If drilling is not related to water well construct	be) ion, skip the remainder of this block			
Purpose of Well (check one): Home 🖌 Industrial Public Supply Irrigation Fish Culture Other:				
If a flowing well, method of flow regulation: Valve Other (describe)				
Static Water Level: <u><u><u></u><u></u><u></u>feet above <u>telow</u> circle one</u></u>) land surface Date measured: $6 - 2^{n} - 0^{n}$			
Method of Measurement (circle one) steel tape electric tape air line other: String [neight				
Well depth: 145 Well grouted to a depth of <u>10</u> feet Type of grout (circle one): Neat Cement Bentonite Mix				
Casing length: 125 feet Casing diameter: 4 inches Type of casing: $p \cup C$				
Screen length: <u>20</u> feet Screen diameter: <u>4</u> inches Type of screen: <u>put</u>				
Screen slot size: $O(D)$ inches Setting depth: From 125 feet to 145 feet				
Type of completion (circle all applicable): Gravel packed Underreamed Telescoped Open hole Natural Development				
Other (describe):				
Top of lap pipe or reduction in casing: feet. If telescoped or more than one screen, describe on next page				

r **7**

Form: OLWR-SWR-1A

J-254

Description of formations encountered must be provided for all


wells and boreholes, unless specifically exempted by regulations

The sketch below only required for water wells

If well telescopes,	show	depths	on	<u>sketch</u> .
Ground Level.		7		

ound Level	Description of Formations Encountered	From (depth)	To (depth)
/	- Clay dirt.	Ground Level	10
	red soud	10	25
	while day	25	35
	Blue clay	35	110
	white soud.	110	145
	the second s		
	······		

If more than one screen, show location of each on sketch

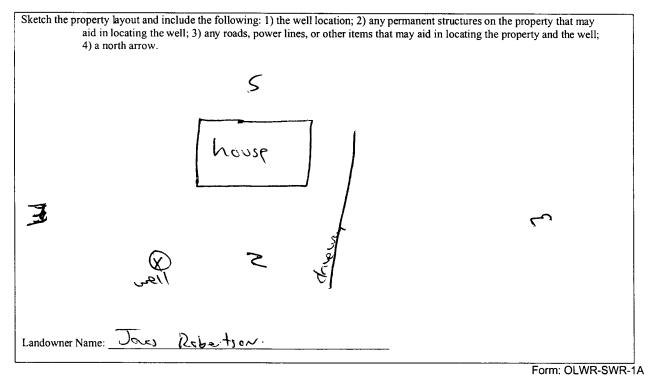

I certify that the well/borehole was drilled, constructed, and completed in accordance with all applicable requirements of the Mississippi Department of Environmental Quality and the Mississippi Department of Health regulations, if applicable, and state

laws. Jones W. Moson 0-620 7-26-07.

now. Man

Print Name of Responsible Licensee and License No.

Date

Signature of Licensee

County: Marshall	Part 2 Pump Installer's Completion Report	For Office Use Only:
Permit #:	Mississippi Department of Environmental Quality Office of Land and Water Resources	Aquifer:
Driller: Jones W-Meson	P.O. Box 10631	7 251
Date completed: 6-29-07	Jackson, MS 39289-0631 (601)961-5210	Well #:
Copy information from block on Part 1	(601)354-6938 (fax)	Elevation:

TD

DI

report must be attached and both parts fued with the Department at the above dadress within 50 days of well completion.			
Well Owner Information	Well Location		
Owner Name: Jones Robertson	Latitude: 34.49,787 Longitude: 89,37.168		
Mailing Address: 67 St Poul rd.	Method of Lat/Long (check one): Conventional Survey,		
	USGS quad, Hand-held GPS, Survey-grade GPS		
Byhalia Ms 38611 City State Zip Code	NE 4 NE 4 Sec 15 T35 R4W		
	Distance Direction Nearest Town		
Telephone No. (701) 336-9916	118 Miles Sw of Victoria		

Pump Type Circle one		Power Type Circle one			
Air Lift	Jet	Submersible	Diesel Engine	Gasoline Engine	Natural Gas
Bucket	Piston	Turbine	Electric Motor	Hand	Tractor PTO
Centrifugal	Rotary	Flowing Well	Windmill	Other (specify):	
Other (specify):			Horse Power Rating	g of Motor: 3/4	
Date Pump Installed	6-28-	-07	Setting Depth:	110	feet
Rated Pump Capacit	ty: 12	Gallons Per Minute	Number of Stages:	11	

Pump Test Data	Method of Measuring Water Level
Date Well Tested: 6- 28-67 Static Water Level (A): 90 Feet Below Land Surface Pumping Water Level (B): Feet Below Land Surface	Circle one Air Line Electric Measuring Line Steel Tape Other (specify): <u>String Loveignt</u>
Painping watch Level (b). Image: Peet Below Land Surface Drawdown [(B) – (A)]: Feet Below Land Surface Test Pumping Rate: Image: Comparison of Comparison of Pump Test (minimum 4 hours): Duration of Pump Test (minimum 4 hours): Image: Comparison of Pump Test (minimum 4 hours):	For flowing well, measured shut in head:

I HEREBY CERTIFY that the above statements are true to the best of	my knowledge.	
Jones withoson and 0-620	Gens v. M	_
Print Name of Pump Installer and License No. (if applicable)	Signature of Pump Installer	
		Form: OLWR-SWR-1B
		RECEIVED

JUL 3 1 2007 BY: OLWR