State V	Vall Danart	
	The Weil Report Part 1 – Driller's Log	
County - Or jo Gtt	nt of Environmental Quality	Aquifer:
	and Water Resources	Well #: J-269
	Box 10631	Well #:
Jackson,	MS 39289-0631	L. S. Elevation:
	)961-5210	E 1 - #
(601)3	54-6938 (fax)	E-log #:
State Law requires that this report be prepared by the la Department at the above address within 30 days of con		
Information on Well Owner		rehole Location
(Landowner if borehole is not for a water well)	201 PL 12 10 10 10 10 10 10 10 10 10 10 10 10 10	" Longitude: <u>&amp;1 ° 37 ' 571 "</u>
Owner Name Dow Looiser	Method of Lat/Long (circle on	Longitude: <u>C1 057 311</u>
Mailing Address: LOT (3		GPS, Survey-grade GPS
timber ridge subdivisor		
Ruli an 2000	240 1/4 DOE 1/4 Sec 01	Twn 35 Kng 4W
Bybalio M3 38611 City State Zip Code	SW SE Distance Direction DI2 Miles Sw	Nearest Town
	Jiz Miles Sw	of Victoria
Telephone No. (901) 489 - 7439		
Well / Bo	rehole Data	
Date drilling started: $\frac{11-2-22}{2}$ Date drilling completed: $\frac{11-2-22}{2}$	Charle depth: <u>151</u>	Hole diameter: <u>6314</u>
Location of the source of any surface water used for drilling:		
Logs run (circle all applicable): No log run Electric Gamma Ray Density Sonic Neutron Other:		
Purpose of borehole (check one): Water Well Geotechnical/Geological Investigation Ground Source Heat Pump		
Seismic SurveyOther (descrited to water well construct	pe) ion, skip the remainder of this blo	ock
Purpose of Well (check one): HomeIndustrial Public Supply Irrigation Fish Culture Other:		
If a flowing well, method of flow regulation: Valve	Other (describe)	
Static Water Level:		
Method of Measurement (circle one) steel tape electric tape air line other: String [ weight		
Well depth: 151 Well grouted to a depth of <u>()</u> feet Type of grout (circle one): Neat Cement Bentonite Mix		
Casing length: <u>141</u> feet Casing diameter: <u>4</u> inches Type of casing: <u>put</u>		
Screen length: 10 feet Screen diameter: 4 inches Type of screen: 000		
Screen slot size: <u>.OLO</u> inches Setting depth: From <u>141</u> feet to <u>151</u> feet		
Type of completion (circle all applicable) Gravel packed Underreamed Telescoped Open hole Natural Development		
Other (describe):		
Top of lap pipe or reduction in casing: feet. If telescoped or more than one screen, describe on next page		
Lange of the second		Form: OLWR-SWR-1A

<u>ه</u> د

UEC 1 0 2007 BY: OLWR

## The sketch below only required for water wells

1


If well telescopes, show depths on si Ground Level\_

Į.

<u>etch</u> .			
	Description of Formations Encountered	From (depth)	To (depth)
	cly dift	Ground Level	30
	red Soud	20	65
	lock	65	62
		67	10
	Black Clark	90	
	Rock		92
	white soud	92	151
	······································		
			-
			_
			-
	·····	_	
	······································		
			1

Description of formations encountered must be provided for all wells and boreholes, unless specifically exempted by regulations

If more than one screen, show location of each on sketch

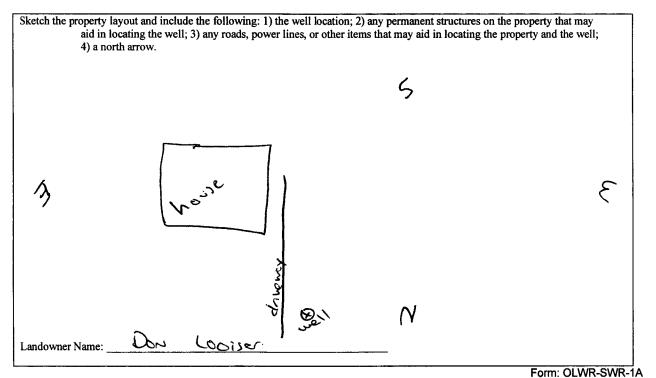

I certify that the well/borehole was drilled, constructed, and completed in accordance with all applicable requirements of the Mississippi Department of Environmental Quality and the Mississippi Department of Health regulations, if applicable, and state laws.

Print Name of Responsible Licensee and License No.

Jones vi Mason

Signature of Licensee

DEC 1 n 2007 -

RECEIVED

BY: OLWR

	STATE WE	LL REPORT	
County: Morshall		art 2 Completion Report	For Office Use Only:
Permit #:	Mississippi Department of Environmental Quality Office of Land and Water Resources		Aquifer:
Driller: Janes J. Mose	P.O. E	Box 10631 IS 39289-0631	Well #: J- 269
Date completed: 11-13-07	(601)	961-5210	Elevation:
Copy information from block on Part 1	J	4-6938 (fax)	
This part of the report must be completed by a licensed water well contractor or a licensed pump installer. A copy of Part 1 of the report must be attached and both parts filed with the Department at the above address within 30 days of well completion.			
Well Owner Information			Location

۰ ،

Owner Name:	Loonise	<u>^</u>	Latitude: 34.49.198 Longitude: 89.37.511
Mailing Address: LOT 13 <u>timber ridge subdivisor</u> <u>Bynolio Ms 386(1)</u> City State Zip Code		<u>SUBAILISON</u> <u>38611</u> Zip Code	Method of Lat/Long (check one): Conventional Survey, USGS quad, Hand-held GPS_ $\checkmark$ Survey-grade GPS_ $\underline{5} \otimes 4 \times \underline{NE} 4$ Sec_ $\underline{31} \times \underline{T3s} \times \underline{4} \otimes$ Distance Direction Nearest Town
Telephone No. (901)	489-74	39	<u> Əla Miles Sw of victoria</u>
	Pump Type Circle one		Power Type Circle one
Air Lift	Jet	Submersible	Diesel Engine Gasoline Engine Natural Gas
Bucket	Piston	Turbine	Electric Motor Hand Tractor PTO
Centrifugal	Rotary	Flowing Well	Windmill Other (specify):
Other (specify):			Horse Power Rating of Motor: 3/4
Date Pump Installed: 11-13-07			Setting Depth:feet
Rated Pump Capacity: _	10	Gallons Per Minute	Number of Stages:

Pump Test Data	Method of Measuring Water Level Circle one
Date Well Tested: 11-13-01   Static Water Level (A): 90   Feet Below Land Surface	Air Line Electric Measuring Line Steel Tape
Pumping Water Level (B):Feet Below Land Surface	Other (specify): <u>String</u> (weight For flowing well, measured shut in head: <u>hrt</u> feet
Drawdown [(B) - (A)]: MA Feet Below Land Surface   Test Pumping Rate: ( ) Gallons Per Minute	Well yielded GPM with a drawdown of
Duration of Pump Test (minimum 4 hours): <u> </u>	feet after <u><u></u>hours of pumping</u>

I HEREBY CERTIFY that the above statements are true to the best	of my knowledge.
Jones in Meson 0-620	Signature of Pump Installen ECEIVED
Print Name of Pump Installer and License No. (if applicable)	Form: OLWR-SWR-1B
	BY: OLWR