	State W	ell Report	For Office Use Only	
County: Marshall	Part 1 – D	riller's Log	For Office Use Only:	
		t of Environmental Quality	Aquifer:	
Permit #:		nd Water Resources Box 2309	Well #:	
Driller: Janes w. Mason		, MS 39225	L. S. Elevation:	
Date drilling completed: 4 ~9~09	, , , , , , , , , , , , , , , , , , ,	061- 5210		
	(001)901	- 5228 (fax)	E-log #:	
State Law requires that this repor	t be prepared by the lice	ense holder responsible for t	he work and filed with the	
Department at the above address			rehole Location	
Information on Well Owner (Landowner if borehole is not for a water well)				
Owner Name Oble Bonner		Latitude: 54° 47°, 30°		
		Method of Lat/Long (circle on		
Mailing Address: LOT 46 U	ictoria Plantation		GPS Survey-grade GPS	
			Twn 3s Rng 4w	
By halia MS City Sta	38611	5P 5W		
City Sta	te Zip Code	Distance Direction	Nearest Town	
Telephone No. (901) 647 ~ 824	16	17/8 Miles SE	of Victoria	
Telephone No. (180)				
	Well / Bore	hole Data		
Date drilling started: 4-9-09 Date drilling completed: 4-9-09 Hole depth: 170 Hole diameter: 6314				
Location of the source of any surface water used for drilling: Method of dosing and volume of Chlorine used in drilling and development:				
Logs run (circle all applicable): No log run Electric Gamma Ray Density Sonic Neutron Other: Name of organization running log(s):				
Purpose of borehole (check one): Water W	ell <u>Geotechnical/Geolo</u>	ogical Investigation Ground	Source Heat Pump	
Seismic S <i>If drilling is not related</i>	Survey Other (describe) to water well construction	n, skip the remainder of this blo	ock	
Purpose of Well (check one): Home I	ndustrial Public Supply	Irrigation Fish Culture	Other:	
If a flowing well, method of flow regulation: Valve Other (describe)				
Static Water Level: 85 feet above of below (circle one) land surface Date measured: 4-9-09				
Method of Measurement (circle one) steel tape electric tape air line other: 5tring luciful				
Well depth: Well grouted to a depth of feet				
Casing length: 160 feet Casing diameter: 4 inches Type of casing: 160				
Screen length: feet Screen diameter: funches Type of screen: for C				
Screen slot size:inches				
Type of completion (circle all applicable)	Gravel packed Under	reamed Telescoped Open	hole Natural Development	
Other (describe):				
Top of lap pipe or reduction in casing:feet. If telescoped or more than one screen, describe on next page				
			Form: OLWR-SWR-1A (04/08)	

RECEIVED

MAY 1 1 2009


BY: OLWR

The sketch below only required for water wells

If well telescopes, show depths on sketch. Ground LevelDescription of formations encountered must be provided for all wells and boreholes, unless specifically exempted by regulations

Description of Formations Encountered	From (depth)	To (depth)
clay dist	Ground Level	5
icd soud	5	30
white soud	30	80
white clay	08	84
while sand	24	125
white clay	125	140
white sand	140	130

If more than one screen, show location of each on sketch

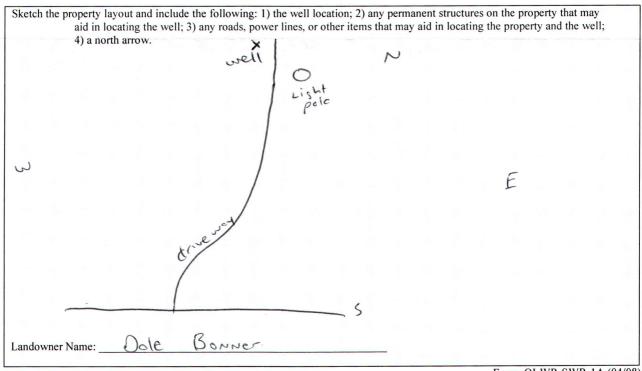

Form: OLWR-SWR-1A (04/08)

I certify that the well/borehole was drilled, constructed, and completed in accordance with all applicable requirements of the Mississippi Department of Environmental Quality and the Mississippi Department of Health regulations, if applicable, and state

laws.

Print Name of Responsible Licensee and License No.

MAY 1 1 2009

BY: OLWR

STATE WELL REPORT

County: Marshall

Part 2

Pump Installer's Completion Report Mississippi Department of Environmental Quality
Office of Land and Water Resources

For Office Use Only:	
Aquifer:	
Well #:	J. 301
Elevation:	

	P.O. Box 2309 Jackson, MS 39225 Well #:
Date completed: 1-9-05	((01)0(1,5210
Copy information from block on Part 1	(601)961-5210 (601)961-5228 (fax) Elevation:
	nsed water well contractor or a licensed pump installer. A copy of Part 1 of the
report must be attached and both parts filed with the	he Department at the above address within 30 days of well completion.
Well Owner Information	Well Location
	Latitude: 34,49,207 Longitude: 89.36,573
Mailing Address: LOT 46 Victor	Method of Lat/Long (check one): Conventional Survey,
	USGS quad, Hand-held GPS, Survey-grade GPS
Byhalie My 38 City State Z	S611 SW 1/2 SE 1/2 Sec 15 T 35 R 4W
City State Z	Distance Direction Nearest Town
Telephone No. (401) 647 - 8246	1718 Miles SE of Victoria
Pump Type	Power Type
Circle one	Circle one
Air Lift Jet Submer	rsible Diesel Engine Gasoline Engine Natural Gas
Bucket Piston Turbine	Electric Motor Hand Tractor PTO
Centrifugal Rotary Flowin	
Other (specify):	Horse Power Rating of Motor: 3/4
Date Pump Installed: 4-9-09	Setting Depth: feet
Rated Pump Capacity:	Per Minute Number of Stages:
Pump Test Data	Method of Measuring Water Level
Date Well Tested: 4-9-09	Circle one
	L Air Line Electric Measuring Line Steel Tape
Static Water Level (A):Feet Below L	and Surface Other (specify): 5tring weight
Pumping Water Level (B): Feet Below La	and Surface
Drawdown [(B) – (A)]:Feet Below L.	and Surface For flowing well, measured shut in head:feet
Test Pumping Rate:Gallons	
	hours feet after $\frac{\partial \mathcal{A}}{\partial \mathbf{A}}$ hours of pumping

Jones willeson O Print Name of Pump Installer and License No. (if applicable) Signature of Pump Installer

Form: OLWR-SME CENTED

MAY 1 1 2009

BY: OLWR