

WELL CONSTRUCTION LOG J0326 MARSHALL

Mr Tommie Woods Marshall Co


WELL LOCATION _____

DATE INSTALLED Sept 21, 2010

TYPE OF WELL 2" PVC

INSTALLATION DESCRIPTION

DESCRIPTION DEPTH (FT.)

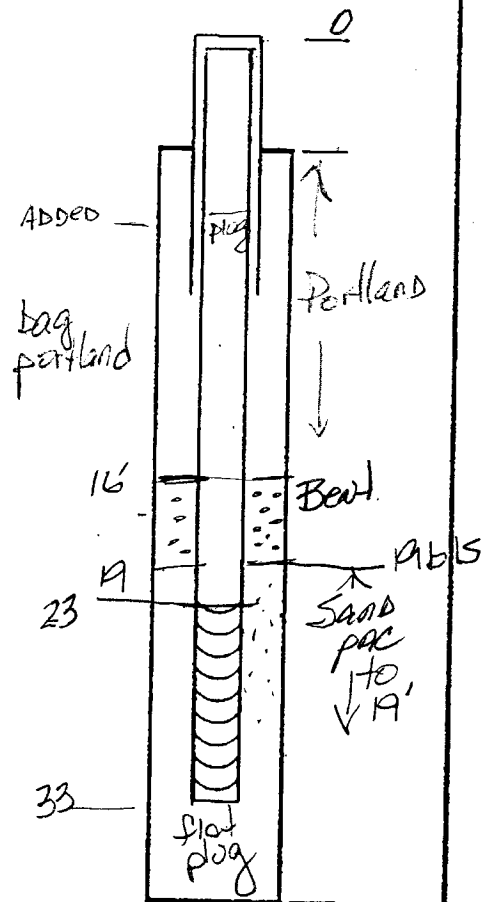

1. HEIGHT OF CASING ABOVE GROUND FLUSH
2. WATER SURFACE ELEV. _____
- a) DEPTH TO SATURATED ZONE _____
3. TOP OF CASING ELEV. _____
4. PROTECTIVE CASING YES NO
- a) CASING LENGTH _____
5. LENGTH OF SCREEN 10ft
6. SIZE\TYPE OF SCREEN .010
7. LENGTH OF SUMP _____
8. TOTAL DEPTH OF BORING 33 HOLE DIAMETER 8"
9. SCREENED INTERVAL 23-33
10. TYPE OF SCREEN FILTER PACK SAND COARSE
QUANTITY USED 3 1/2 SIZE U/C
11. DEPTH TO TOP OF FILTER ↳ D. McCray to do sieve
12. TYPE OF SEAL Bentonite
QUANTITY USED 1 bag pellets
13. DEPTH TO TOP OF SEAL 16ft
14. TYPE OF GROUT Portland
GROUT MIXTURE 12% bent. @ 3 bags port 1 bag bent.
METHOD OF PLACEMENT _____
15. COMMENTS Sandy shaly sand pac
orange/orange water sand mixture

WL - let well sit overnight to allow sand to sink

Grout mixture by guidelines of Shelby Co Health Dept
(12% bent. @ 3 bags port 1 bag bent.)

~~WL @ 16ft~~ on 9/24/10 @ 0645 = 16.20 b/s

345125/894003 G00136

Marshall Co.

LOCATION OF BORING AS		JOB NO. 6	CLIENT	LOCATION WOODS
		DRILLING METHOD: <u>HOLLOWSTEM AUGER</u>		BORING NO.
		SAMPLING METHOD: <u>5'</u>		SHEET 1 OF 1
DATUM		ELEVATION		DRILLING
WATER LEVEL	1500	1635		START TIME
TIME	22.00	12.50		FINISH TIME
DATE	9/21/10	9/21/10		DATE
CASING DEPTH	23'	23'		DATE
				9/21/10 9/21/10

SAMPLER TYPE	INCHES DRIVEN INCHES RECORDED	DEPTH OF CASING	SAMPLE NO. SAMPLE DEPTH	BLOWS/FT. SAMPLER	VAPOR CONCENTRATIONS (PPM)	DEPTH IN FEET	SOIL GRAPH	SURFACE CONDITIONS: <u>DRY, GRASS, HARD GRAVEL, SILT</u>
								<u>N 34° 51' 25"</u>
								<u>WD89 40 02" elev =</u>
						0		<u>1' return only 2' deep, hard</u>
						1		<u>0-2 silt, light, dark yellowish orange</u>
						2		<u>small roots, some organic matter</u>
						3		<u>2-6 - top @ 2' same as above w/ color change</u>
						4		<u>no more @ 4 ft</u>
						5		<u>silt @ 2 turning to more clay @ 4</u>
						6		<u>increasing moisture @ 5-6 moist, clay</u>
						7		<u>organics increasing moist</u>
						8		<u>6-11 - silt pale yellowish green, mottled</u>
						9		<u>to moist, increasing organics @ 9-10</u>
						10		<u>sandy silt @ 10-11</u>
						11		<u>pale brown @ 6 to med. yellow brown @ 11</u>
						12		<u>mottling increasing w/ depth, moist</u>
						13		<u>11-16 sandy silt dk brownish orange 11.8 turning</u>
						14		<u>to silt w/ organics @ 12' back to clay</u>
						15		<u>silty sand @ 13 yellowish orange turning to</u>
						16		<u>mod. clay, silt → orange brown @ 15-16</u>
						17		<u>16-21 clay med. dark orange br. to gray turning</u>
						18		<u>to mostly gray clay @ 21 sand -</u>
						19		<u>line w/ silty clay mostly clay, moisture 21</u>
						20		<u>grayish orange</u>
						21		<u>21-26 moist silt, clay, some gravel @ 22'</u>
						22		<u>then sandy-med. orange brown layer,</u>
						23		<u>? 25-26 wet to moist med grain sand</u>
						24		<u>26-31 - sampler all wet, - loose sand</u>
						25		<u>orange, brown wet</u>
						26		<u>@ 1500 to inside casing ~ 22' # bls</u>
						27		<u>@ 1635 to " " = 12.5 bls</u>
						28		
						29		<u>Came back on 9/24/10 @ 0645</u>
						30		<u>WL = 16.21 bls</u>

DRILLING CONTR. TRI-STATE TESTING

BY M. MANNING DATE 9/2/10 CHK'D BY