	Vell Report Driller's Log	For Office Use Only:	
Mississippi Department of Environmental Quality		Aquifer:	
Permit #: 0/63 Driller: <u>Larry Carpentee</u> Driller: <u>Larry Carpentee</u> Driller: <u>Sarry Carpentee</u> Driller: <u>Marry Carpentee</u> Driller: <u>Marry Carpentee</u> Driller: <u>Sarry Carpentee</u> Driller: <u>Marry Carpentee</u> Driller: <u>Driller</u>		Well #:	
Jackson, Mis 39289-0631		L. S. Elevation:	
Date drilling completed: $3 - 2 - 40$ (601)961-5210 (601)354-6938 (fax)		E-log #:	
State Law requires that this report be prepared by the license holder responsible for the work and filed with the Department at the above address within 30 days of completion of drilling of the well or borehole.			
Information on Well Owner		ehole Location	
(Landowner if borehole is not for a water well)	Latitude: <u>34° 47' 286</u>	Longitude: <u>99°37, 165</u>	
Owner Name Rappa Custom Homes	Method of Lat/Long (circle one	A 0 1	
Mailing Address: 4326 Hury 178 West	USGS quad, Hand-held C	GPS, Survey-grade GPS	
Rod Banka mc 50611	5E 1/ SE 1/4 Sec 28	Twn 35 Rng 4W	
Kod Banks MS 38611 City State Zip Code Telephone No. ( <u>613) 258. 2114</u>	Distance Direction	Nearest Town Red Banks	
	······································		
Well / Borehole Data			
Date drilling started: $\underline{\$-1/12}$ Date drilling completed: $\underline{\$-2/12}$ Hole depth: $\underline{160}$ Hole diameter: $\underline{\$}''$			
Location of the source of any surface water used for drilling: Well Water, Method of dosing and volume of Chlorine used in drilling and development: <u>IL fd. Chlorice to 1000 Mal Wate</u>			
Logs run (circle all applicable): No log rup Electric Gamma Ray Density Sonic Neutron Other: Name of organization running log(s):			
Purpose of borehole (check one): Water Well X Geotechnical/Geological Investigation Ground Source Heat Pump			
Seismic SurveyOther (describe) If drilling is not related to water well construction, skip the remainder of this block			
Purpose of Well (check one): Home 🖌 Industrial Public Supply Irrigation Fish Culture Other:			
If a flowing well, method of flow regulation: Valve Other (describe)			
Static Water Level: <u>75</u> feet above or below (circle one) land surface Date measured: <u>8-2/-/2</u>			
Method of Measurement (circle one) steel tape electric tape air line other:			
Well depth: <u>/60</u> Well grouted to a depth of <u>/0</u> feet Type of grout (circle one) Neat Cement Bentonite Mix			
Casing length: <u>90</u> feet Casing diameter: <u>4</u> inches Type of casing: <u>PUC</u>			
Screen length: <u>10</u> feet Screen diameter: <u>4</u> inches Type of screen: <u>100</u>			
Screen slot size: . 013 inches Setting depth: From 90 feet to 100 feet			
Type of completion (circle all applicable): Gravel packed Underreamed Telescoped Open hole Natural Development			
Other (describe):			
Top of lap pipe or reduction in casing:feet. If tel	escoped or more than one screen	, describe on next page	
		Form: OLWR-SWR-1A	
		RECEIVED	
		SEP 2 1 2012	

	1 in 14 1 f.
RY,	OLMR

٠

16

30

54

60

82

100

From (depth) To (depth)

Ground Level

٥

6


70


60

8Z

Description of formations encountered must be provided for all wells and boreholes, unless specifically exempted by regulations

## The sketch below only required for water wells

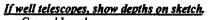

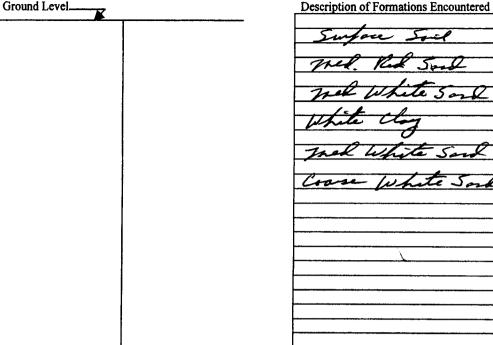

If more than one screen, show location of each on sketch

Sketch the property layout and include the following: 1) the well location; 2) any permanent structures on the property that may aid in locating the well; 3) any roads, power lines, or other items that may aid in locating the property and the well; 4) a north arrow. Hove Henorde Re Rappa Custom Homes Landowner Name: Form: OLWR-SWR-1A

I certify that the well/borehole was drilled, constructed, and completed in accordance with all applicable requirements of the Mississippi Department of Environmental Quality and the Mississippi Department of Health regulations, if applicable, and state

laws <u>Carpenter #0.162</u> 8-23-12 Long Carpo sponsible Licensee and License No. Date Signature of Licensee pater AFORMED XIHU SEP 2 1 797. Print Name of Responsible Licensee and License No.

AN OIMA

STATE WELL REPORT		
Permit #: 0-163 Permit #: 0-163 Drilleri Lavy Coupenter Date completed: 8-21-2013 Copy information from block on Part 1 This part of the report must be completed by a licensed water well report must be attached and both parts filed with the Department of Well Owner Information Owner Name: Report Custom Homes	Part 2     Pump Installer's Completion Report     Mississippi Department of Environmental Quality   Aquifer:     Mississippi Department of Environmental Quality   Aquifer:     Mississippi Department of Environmental Quality   Aquifer:     Mississippi Department of Environmental Quality   Mississippi Department of Environmental Quality     Mississippi Department of Environmental Quality   Mississippi Department of Environmental Quality     Mississippi Department of Environmental Quality   Mississippi Department of Environmental Quality     Mississippi Department of Environmental Quality   Mississippi Department of Environmental Quality     Mississippi Department of Environmental Quality   Mississippi Department of Environmental Quality     Mississippi Department of Environmental Quality   Mississippi Department System     Mississippi Department of Environmental Quality   Mell #     Mississippi Department of Environmental Quality   Mell #     Mississippi Department at the above address within 30 days of well completion.     Well Owner Information   Well Location     Reppa   Missistry Power     Missistry Homes   Latitude: <u>34</u> 47 28 Longitude: <u>89 57. 165</u>	
Mailing Address: <u>4326 Hwy178west</u> <u>Bed Banks MS 38611</u> City State Zip Code Telephone No. <u>663 252 - 2114</u>	Method of Lat/Long (check one): Conventional Survey, USGS quad, Hand-held GPS_, Survey-grade GPS 	
Pump Type   Circle one	Power Type Circle one	
Air Lift Jet Submersible Bucket Piston Turbine	Diesel Engine     Gasoline Engine     Natural Gas       Electric Motor     Hand     Tractor PTO	
Centrifugal   Rotary   Flowing Well     Other (specify):	Windmill   Other (specify):     Horse Power Rating of Motor:   3/4     Setting Depth:   9.5     feet     Number of Stages:   1	
Pump Test Data   Method of Measuring Water Level     Date Well Tested:   8-21-12     Static Water Level (A):   75     Feet Below Land Surface   Air Line     Pumping Water Level (B):   82     Feet Below Land Surface   Other (specify):     Drawdown [(B) - (A)]:   7     Feet Below Land Surface   For flowing well, measured shut in head:     Test Pumping Rate:   17     Gallons Per Minute   Well yielded     Duration of Pump Test (minimum 4 hours):   4		
I HEREBY CERTIFY that the above statements are true to the best of my knowledge.     Larry Carpenter #0.163   Lam Carpenter     Print Name of Pump Installer and License No. (if applicable)   Signature of Pump Installer     Signature of Pump Installer   Signature of Pump Installer     BY: OLME		

•

۲