	State Well Report		
County Mar shall-	Part 1 – Driller's Log	For Office Use Only:	
Ming	ssippi Department of Environmental Quality	Aquifer:	
Permit #:	Office of Land and Water Resources	Well #: #	
Driller: Jones w. Mason.	P.O. Box 10631		
	Jackson, MS 39289-0631	L. S. Elevation: <u>J 344</u>	
Date drilling completed: 3-31-06	(601)961-5210 (601)354-6938 (fax)	E-log #:	
	(001)554-0958 (lax)	E-log #:	
State Law requires that this report be pu Department at the above address within	epared by the license holder responsible for 1 30 days of completion of drilling of the well	the work and filed with the l or borehole.	
Information on Well Owner	Well or Be	prehole Location	
(Landowner if borehole is not for a wa	ter well)	" I and the R9 . 38 . 763"	
Owner Name Lorry Newsom-		Longitude: 310 - 0	
Mailing Address: 200 petty de		<u>''' Longitude:</u> <u>89 • 38 , 253,</u> ne): Conventional Survey,	
	USGS quad, Hand-held	GPS Survey-grade GPS	
R.L. IN	38611 DE 1/ SE 1/ Sec 10	Twn 35 Rng 500	
Bytaliz MS City State	Zin Code Distance NW 17	Twn 35° Rng 5° Nearest Town	
	$\frac{1314}{\text{Miles}} \text{ SE}$	of where sources	
Telephone No. (901) 485 - 3734			
	Well / Borehole Data		
Date drilling started: 3-31-06 Date drilling completed: 3-31-06 Hole depth: 110 Hole diameter: 8'			
Location of the source of any surface water used Method of dosing and volume of Chlorine used i	n drilling and development:		
Logs run (circle all applicable): No log nur Electric Gamma Ray Density Sonic Neutron Other:			
Purpose of borehole (check one): Water Well	Geotechnical/Geological Investigation Ground	I Source Heat Pump	
Seismic Survey	Other (<i>describe</i>)		
If drilling is not related to water well construction, skip the remainder of this block			
Purpose of Well (check one): Home / Industria	lPublic Supply Irrigation Fish Culture	Other:	
If a flowing well, method of flow regulation: Val-			
Static Water Level: 75 feet above (r below) (circle one) land surface Date measured: 3-31-00			
Method of Measurement (circle one) steel tape electric tape air line other: Strong (_e.g.uk			
Well depth: <u>110</u> Well grouted to a depth of <u>10</u> feet Type of grout (circle one): Neat Cement Bentonite Mix			
Casing length: 100 feet Casing diameter: 4 inches Type of casing: pJC			
Screen length: <u>()</u> feet Screen diameter: <u>()</u> inches Type of screen: <u>p.c.</u>			
Screen slot size: <u>010</u> inches Setting depth: From <u>100</u> feet to <u>110</u> feet			
Type of completion (circle all applicable): Gravel packed Underreamed Telescoped Open hole Natural Development			
Other (describe):			
Top of lap pipe or reduction in casing:feet. <u>If telescoped or more than one screen, describe on next page</u>			

.

Form: OLWR-SWR-1A

MAY 0 3 2006 BY: OLWR

5344


The sketch below only required for water wells

If well telescopes,	show	depths	<u>o</u> n	sketch.
Ground Level.		7		

Description of Formations Encounter	ed From (depth)	Fo (depth ろい
suchite sound	30	110
		h
		<u> </u>
	· · · · · · · · · · · · · · · · · · ·	j

Description of formations encountered must be provided for all wells and boreholes, unless specifically exempted by regulations

If more than one screen, show location of each on sketch

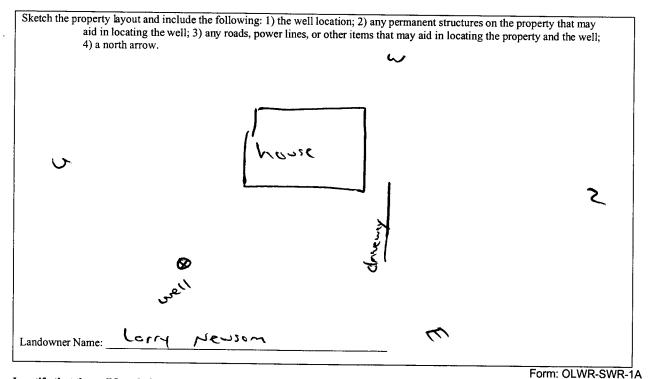

I certify that the well/borehole was drilled, constructed, and completed in accordance with all applicable requirements of the Mississippi Department of Environmental Quality and the Mississippi Department of Health regulations, if applicable, and state laws.

Date

Janes W. Mosar 0-620 4-28-06

per w. N .

Print Name of Responsible Licensee and License No.

Signature of Licensee

MAY 0 3 2006 BY: OLWR

STATE WELL REPORT				
County: Mershall	Part 2 Pump Installer's Completion Report	For Office Use Only:		
Permit #:	Mississippi Department of Environmental Quality	Aquifer: T344		
Driller: Jones W. Mason	Office of Land and Water Resources P.O. Box 10631			
Date completed: 3-31-06	Jackson, MS 39289-0631 (601)961-5210	Well #:		
<u>Copy information from block on Part 1</u>	(601)354-6938 (fax)	Elevation:		

This part of the report must be completed by a licensed water well contractor or a licensed pump installer. A copy of Part 1 of the
report must be attached and both parts filed with the Department at the above address within 30 days of well completion.Well Owner InformationWell Location

Owner Name: Lorry Newson	Latitude 34.49.517 Longitude: 89-35-763.
Mailing Address: 220 petty drive.	Method of Lat/Long (check one): Conventional Survey, USGS quad, Hand-held GPS, Survey-grade GPS
	USGS quad, Hand-held GPS, Survey-grade GPS
Byhalin Ms 38611 City State Zip Code	NE 4 SE 4 Sec 18 T 35 R Sec
	Distance Direction Nearest Town
Telephone No (931) $485 - 2724$	13/4 William SE of WIDGSON (

	Pump Type Circle one			Power Type Circle one	
Air Lift	Jet (Submersible	Diesel Engine	Gasoline Engine	Natural Gas
Bucket	Piston	Turbine	Electric Motor	Hand	Tractor PTO
Centrifugal	Rotary	Flowing Well	Windmill	Other (specify):	
Other (specify):			Horse Power Rating	of Motor: 3/4	
Date Pump Installed:	3-31-06		Setting Depth:	95	feet
Rated Pump Capacity:	12	Gallons Per Minute	Number of Stages:	٤١	

Pump Test Data	Method of Measuring Water Level		
Date Well Tested: 3-31-06	Circle one		
Static Water Level (A): 75 Feet Below Land Surface	Air Line Electric Measuring Line Steel Tape		
Pumping Water Level (B):	Other (specify): <u>String</u> (weight		
Drawdown [(B) – (A)]: Feet Below Land Surface	For flowing well, measured shut in head:feet		
Test Pumping Rate: 12 Gallons Per Minute	Well yielded GPM with a drawdown of		
Duration of Pump Test (minimum 4 hours): <u> </u>	feet after <u><u></u><u></u><u></u><u></u> hours of pumping</u>		

I HEREBY CERTIFY that the above statements are true to the best o	of my knowledge.	
Jenes W. Mason. 0-620	Gens Man	
Print Name of Pump Installer and License No. (if applicable)	Signature of Pump Installer	
	Form: O	RECEIVED

MAY 0 3 2006 BY: OLW R