

Marshall
 J 200
 12-19-75

MISSISSIPPI
 BOARD OF WATER COMMISSIONERS
 416 North State Street
 Jackson, Mississippi 39201

156

WATER WELL DRILLERS LOG

W.A. Mason
 Water Well Contractor Marshall

12-19-75 date well completed
 W.A. Mason firm name
 Marshall county well located

LANDOWNER:
 Johnny Raulls
 Victoria Meas.
 (mailing address)

description of formations encountered	from to	
	ft	ft
Clay Soil	0	10
Red Sand	10	50
White Sand	50	210

WELL LOCATION:
 sec. 10 T. 3 N. R. 4 E.
 1/2 miles S of Victoria
 (distance) (direction) (nearest town)

WELL PURPOSE: Home
 (home, irrigation, municipal, industrial)

- WELL COMPLETION DATA:
- (1) diameter (inches) 4"
 - (2) total depth (feet) 210'
 - (3) static water level (feet) 143' below top of ground.
 - (4) casing Plastic, 198'
 (material) (depth)
 4" (size) If telescope see back.
 - (5) screen 12' 198'
 (length) (depth to top)
 4" (size) Plastic (material)
 - (6) pump 3/4 10
 (HP) (yield gpm)
 electric (type power)
 - (7) electric log No
 (yes or no)
 (organization running log)
 - (8) how well bottom plugged Cap


RECEIVED
 FEB 17 1976

MISS. BD. OF WATER COMMISSIONERS

DRILLERS REMARKS:

If well telescopes please sketch and show depths.

GROUND LEVEL

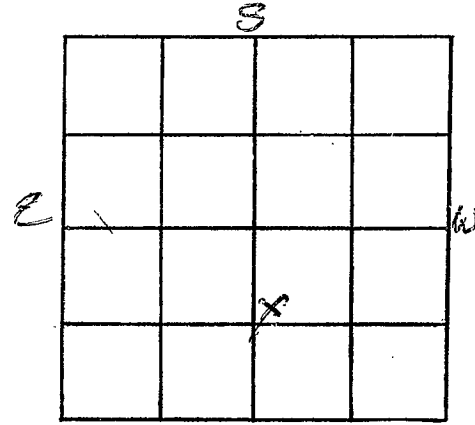

SECTION 10

Please indicate well location X.

ADDITIONAL INFORMATION

If more than one screen, show locations of each on sketch.