

Marshall
 J 2002
 1-16-76

MISSISSIPPI
 BOARD OF WATER COMMISSIONERS
 416 North State Street
 Jackson, Mississippi 39201

15E

WATER WELL DRILLERS LOG

1-16-1976 ^{W.A. Mason} Water Well Co., Inc. Marshall
 date well completed firm name county well located

LANDOWNER:
Bob Kimball
R.F.D. - Byhalia Miss
 (mailing address)

description of fomations encountered	from	to
<u>Clay</u>	<u>0</u>	<u>8</u>
<u>white clay</u>	<u>8</u>	<u>25</u>
<u>white sand</u>	<u>25</u>	<u>105</u>

WELL LOCATION:
 sec. 18 T. 3 N. R. 3 E. W
1 1/2 miles EAST of Marshall
 (distance) (direction) (nearest town)

WELL PURPOSE: Home
 (home, irrigation, municipal, industrial)

WELL COMPLETION DATA:

(1) diameter (inches) 4"

(2) total depth (feet) 103'

(3) static water level (feet) 33' below above top of ground.

(4) casing PVC Plastic 93'
 (material) (depth)
4"
 (size) if telescope see back.

(5) screen 10' - 93'
 (length) (depth to top)
4" PVC Plastic
 (size) (material)


(6) pump 3/4 12
 (HP) (yield gpm)
electric
 (type power)

(7) electric log No
 (yes or no)

(organization running log)


(8) how well bottom plugged
cap on screen

DRILLERS REMARKS:

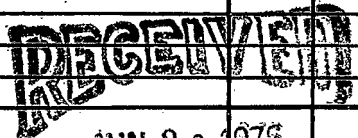

If well telescopes please sketch and show depths.

GROUND LEVEL

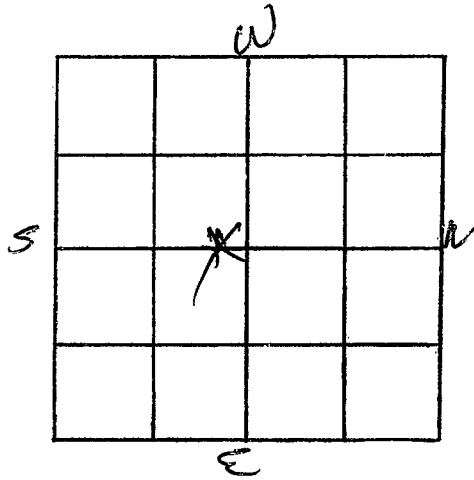

SECTION 18

Please indicate well location X.

ADDITIONAL INFORMATION

If more than one screen, show locations of each on sketch.