

MARSHALL

J 2004

3-2-76

MISSISSIPPI BOARD OF WATER COMMISSIONERS
416 North State Street
15E Jackson, Mississippi 39201

WATER WELL DRILLERS LOG

3-2-76
date well completed

1976 Hicks Well Co
firm name

Marshall
county well located

LANDOWNER: BENNIE STUMP

description of formations encountered

from

to

RT-4 BOX H 93

Byhalia Miss
(mailing address)

Red CLAY
Red SAND
W. SAND

0 15
15 50
50 120

WELL LOCATION:

sec 25 T-3 N R-4 E

10 miles South of Byhalia
(distance) (direction) (nearest town)

WELL PURPOSE: Home
(home, irrigation, municipal, industrial)

WELL COMPLETION DATA:

- (1) diameter (inches) 4"
- (2) total depth (feet) 120
- (3) static water level (feet) 70 below above top of ground.
- (4) casing PVC 113
(material) (depth)

(size) if telescope see back.

- (5) screen 7' 7
(length) (depth to top)

4" INSIDE ROCK
(size) (material) PVC

- (6) pump 1/2 10
(HP) (yield gpm)

EIC
(type power)

- (7) electric log NO
(yes or no)

(organization running log)

- (8) how well bottom plugged CAP


DRILLERS REMARKS:

RECORDED
INDEXED
MAR 27 1976

NO. OF WATER COMMISSIONERS

If well telescopes please sketch and show depths.

GROUND LEVEL

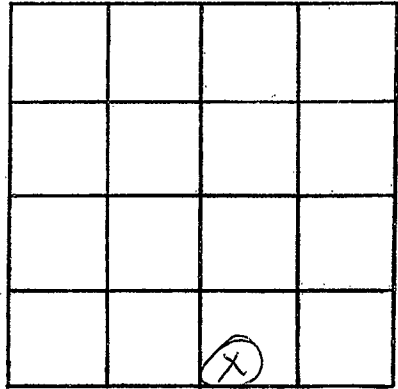

SECTION _____

Please indicate well location X.

ADDITIONAL INFORMATION

If more than one screen,
show locations of each on sketch.