

MARSHALL
 J 2005
 3-15-76

MISSISSIPPI
 BOARD OF WATER COMMISSIONERS
 416 North State Street
 Jackson, Mississippi 39201

WATER WELL DRILLERS LOG

3-15-76 date well completed
 W. A. Mason firm name
 15E 76 Water Well Conts. Marshall county well located

LANDOWNER:	description of formations encountered	from	to
(mailing address)			
J. C. Burns	clay silt	10	12
RFD Byhalia Miss	Red sand	12	50
	white sand	50	122

LANDOWNER:

description of formations encountered

from to

WELL LOCATION:

sec. 18 T. 3 N. R. 3 E
 1 1/2 miles East of Warsaw
 (distance) (direction) (nearest town)

WELL PURPOSE: Home
 (home, irrigation, municipal, industrial)

WELL COMPLETION DATA:

- (1) diameter (inches) 4"
- (2) total depth (feet) 122'
- (3) static water level (feet) 57' below top of ground.
- (4) casing PVC Plastic 1 1/2' (material) (depth)
 4" (size) If telescope see back.
- (5) screen 10', 112' (length) (depth to top)
 4" PVC Plastic (size) (material)
- (6) pump 1/3 (HP) 10 (yield gpm)
 electric (type power)
- (7) electric log NO (yes or no)

(organization running log)

(8) how well bottom plugged
 Cap on screen


DRILLERS REMARKS:

RECEIVED
 JUN 28 1976

MISS. BD. OF WATER COMM.

If well telescopes please sketch and show depths.

GROUND LEVEL

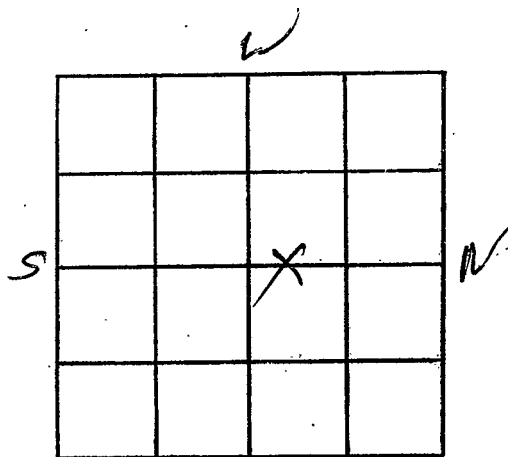

SECTION 18

Please indicate well location X.

ADDITIONAL INFORMATION

If more than one screen, show locations of each on sketch.