

MARSHALL
 J 2006
 4-3-76

MISSISSIPPI
 BOARD OF WATER COMMISSIONERS
 416 North State Street
 Jackson, Mississippi 39201

WATER WELL DRILLERS LOG


April 3 1976 Carl Jones Well Co Marshall
 date well completed firm name county well located

| LANDOWNER: | description of formations encountered | from | to |
|--|---------------------------------------|------|-----|
| Roosevelt Sucas | | | |
| Victoria Mills (mailing address) | Topsoil & clay | 0 | 16 |
| | sand | 16 | 50 |
| | clay | 50 | 55 |
| | sand | 55 | 80 |
| | clay | 80 | 86 |
| | sand | 86 | 150 |
| WELL LOCATION: | | | |
| sec. 3 T. 3 N. R. 4 E S W | | | |
| 1/2 miles East of Victoria (distance) (direction) (nearest town) | | | |
| WELL PURPOSE: Home (home, irrigation, municipal, industrial) | | | |
| WELL COMPLETION DATA: | | | |
| (1) diameter (inches) 2" | | | |
| (2) total depth (feet) 150 | | | |
| (3) static water level (feet) 90 below top of ground. | | | |
| (4) casing plastic, 140' (material) (depth) | | | |
| 2" if telescope see back. (size) | | | |
| (5) screen 10' 140' (length) (depth to top) | | | |
| 2" - 013 plastic (size) (material) | | | |
| (6) pump 1 3 (HP) (yield gpm) | | | |
| Electric (type power) | | | |
| (7) electric log no. (yes or no) | | | |
| (organization running log) | | | |
| (8) how well bottom plugged plastic cap | | | |
| DRILLERS REMARKS: | | | |

MAY - 5 1976
 MISS. BD. OF WATER COMMISSIONERS

If well telescopes please sketch and show depths.

GROUND LEVEL

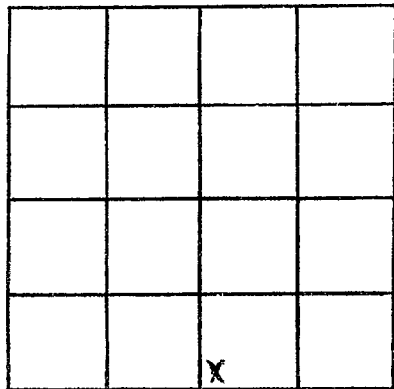

SECTION 3

Please indicate well location X.

ADDITIONAL INFORMATION

If more than one screen, show locations of each on sketch.