

MARSHALL
J 2007,
4-12-76

MISSISSIPPI
 BOARD OF WATER COMMISSIONERS
 416 North State Street
 Jackson, Mississippi 39201

WATER WELL DRILLERS LOG

15E W.A. Mason Marshall
 date well completed 4-12-1976 firm name Water Well Contractor county well located Marshall

LANDOWNER:

M.R. Luthrel
RFD, Holly Springs
 (mailing address)

description of formations encountered

description of formations encountered	from	to
<u>clay dirt</u>	<u>0</u>	<u>20</u>
<u>Red sand</u>	<u>20</u>	<u>50</u>
<u>white sand</u>	<u>50</u>	<u>182</u>

WELL LOCATION:

sec 36 T 3 N R 4 E
5 3/4 miles WEST Holly Springs
 (distance) (direction) (nearest town)

WELL PURPOSE:


Home
 (home, irrigation, municipal, industrial)

WELL COMPLETION DATA:

- (1) diameter (inches) 4"
- (2) total depth (feet) 182
- (3) static water level (feet) 120 below top of ground.
- (4) casing Pvc Plastic 172'
 (material) (depth)
4" if telescope see back.
 (size)
- (5) screen 10', 172'
 (length) (depth to top)
4", Pvc Plastic
 (size) (material)
- (6) pump 1/2 10
 (HP) (yield gpm)
electric
 (type power)
- (7) electric log No
 (yes or no)
 (organization running log)


(8) how well bottom plugged cap on screen

DRILLERS REMARKS:

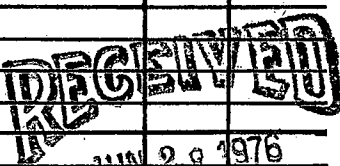

If well telescopes please sketch and show depths.

GROUND LEVEL

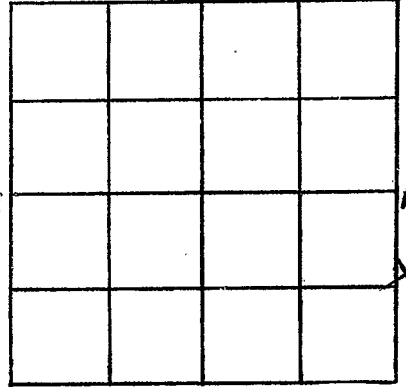

SECTION 36

Please indicate well location X.

ADDITIONAL INFORMATION

If more than one screen, show locations of each on sketch.