

Marshall  
J 208  
5-5-76

MISSISSIPPI  
 BOARD OF WATER COMMISSIONERS  
 416 North State Street  
 15E Jackson, Mississippi 39201

WATER WELL DRILLERS LOG

5-5-76 1976 Sub. Smith Well Sr. Marshall  
 date well completed firm name county well located

LANDOWNER:	description of formations encountered	from	to
<u>H-Q - Croughs</u>			
<u>Bygalia, Mr.</u> (mailing address)	<u>red sand</u>	<u>5</u>	<u>90</u>
	<u>Clay 11</u>	<u>90</u>	<u>125</u>
WELL LOCATION: sec. <u>7</u> T <u>3</u> N <u>2</u> R <u>4</u> E <u>4</u> miles <u>SE</u> of <u>Bygalia</u> (distance) (direction) (nearest town)			
WELL PURPOSE: (home, irrigation, municipal, industrial)			
WELL COMPLETION DATA:			
(1) diameter (inches) <u>4"</u>			
(2) total depth (feet) <u>125</u>			
(3) static water level (feet) <u>95'</u> below top of ground.			
(4) casing <u>plastic</u> <u>125'</u> (material) (depth)			
(size) If telescope see back.			
(5) screen <u>10'</u> <u>115'</u> (length) (depth to top)			
<u>4"</u> <u>plastic</u> (size) (material)			
(6) pump <u>12</u> <u>10</u> (HP) (yield gpm)			
<u>Elec.</u> (type power)			
(7) electric log <u>(yes or no)</u>			
(organization running log)			
(8) how well bottom <u>plugged</u>			
DRILLERS REMARKS:			


**RECEIVED**

SEP 20 1976

MISS. BD. OF WATER COMMISSIONERS

If well telescopes please sketch and show depths.

GROUND LEVEL

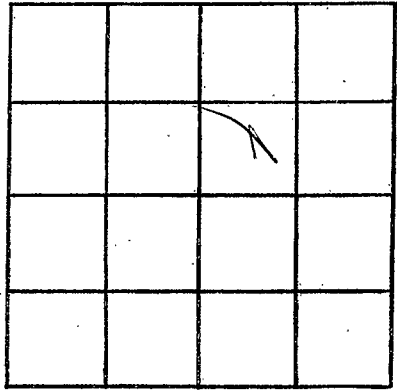

SECTION \_\_\_\_\_

Please indicate well location X.

ADDITIONAL INFORMATION

If more than one screen,  
show locations of each on sketch.