

**MARSHALL**  
 J 2011  
 5-20-76

MISSISSIPPI  
 BOARD OF WATER COMMISSIONERS  
 416 North State Street  
 Jackson, Mississippi 39201

WATER WELL DRILLERS LOG

5-20-1976 *H. A. Peterson & Son* *Marshall*  
 date well completed firm name county well located


LANDOWNER:  
*Charles & Robin*  
*Red Banks*  
 (mailing address)

description of formations encountered	from	to
<i>Red Clay</i>	0	30
<i>Red sand</i>	30	90
<i>White clay</i>	90	110
<i>White sand</i>	110	148

WELL LOCATION:  
 sec. 3 T. 3 N. R. 4 E  
3 1/2 miles N of Red Bank  
 (distance) (direction) (nearest town)

WELL PURPOSE:  
 (home, irrigation, municipal, industrial)

- WELL COMPLETION DATA:
- (1) diameter (inches) 4 1/2
  - (2) total depth (feet) 140
  - (3) static water level (feet) 90 below above top of ground.
  - (4) casing PVC (material) (depth) \_\_\_\_\_  
 \_\_\_\_\_ (size) if telescope see back.
  - (5) screen 10 1/2 (length) (depth to top) \_\_\_\_\_  
 \_\_\_\_\_ (size) \_\_\_\_\_ (material)
  - (6) pump 3 (HP) 15 (yield gpm)  
 \_\_\_\_\_ (type power)
  - (7) electric log (yes or no) \_\_\_\_\_  
 \_\_\_\_\_ (organization running log)
  - (8) how well bottom plugged 0

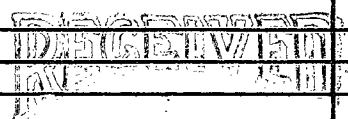


JUN - 4 1976

DRILLERS REMARKS:

If well telescopes please sketch and show depths.

GROUND LEVEL

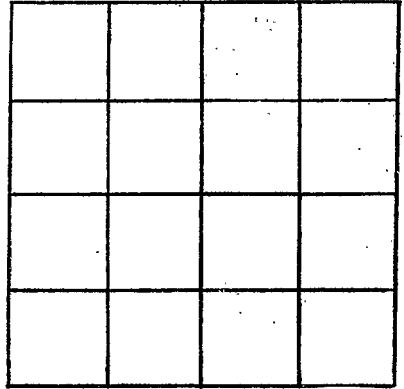

SECTION \_\_\_\_\_

Please indicate well location X.

ADDITIONAL INFORMATION

If more than one screen, show locations of each on sketch.