

MARSHALL
J 2012
5-26-76

MISSISSIPPI
 BOARD OF WATER COMMISSIONERS
 416 North State Street
 Jackson, Mississippi 39201

15E

WATER WELL DRILLERS LOG

5-26-76 date well completed
 1976 Bob Smith Well Serv. firm name
 Marshall county well located

LANDOWNER:
 Earl Wilson
 Byhalia, Miss.
 (mailing address)

description of formations encountered	from	to
top sand	0	5
red clay	5	30
red sand	30	50
white clay	50	95
" sand	95	145

WELL LOCATION:
 sec. 7 T. 3 N. R. 4 E.
 4 miles S of Byhalia
 (distance) (direction) (nearest town)

WELL PURPOSE:
 (home, irrigation, municipal, industrial)


- WELL COMPLETION DATA:
- (1) diameter (inches) 4"
 - (2) total depth (feet) 145'
 - (3) static water level (feet) 105' below top of ground.
 - (4) casing plastic, 145' (material) (depth)
 (size) If telescope see back.
 - (5) screen 10', 135' (length) (depth to top)
4", plastic (size) (material)
 - (6) pump 1/3, 5 (HP) (yield gpm)
Elec. (type power)
 - (7) electric log (yes or no) (no)
 (organization running log)
 - (8) how well bottom plugged (circled)

DRILLERS REMARKS:

RECEIVED
 SEP 20 1976
 MISS. Bd. OF WATER COMMISSIONERS

If well telescopes please sketch and show depths.

GROUND LEVEL

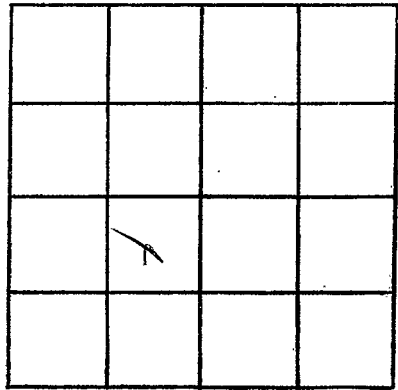

SECTION _____

Please indicate well location X.

ADDITIONAL INFORMATION

If more than one screen,
show locations of each on sketch.