

MARSHALL
J 2013
6-25-76

MISSISSIPPI
 BOARD OF WATER COMMISSIONERS
 416 North State Street
 Jackson, Mississippi 39201

WATER WELL DRILLERS LOG

June 25 19 76 Earl Jones Well Co Marshall
 date well completed firm name county well located

LANDOWNER: C. S. Wash.
Red Banks Miss. RT 1
 (mailing address)

WELL LOCATION:
 sec 3 T 3 N R 4 E
 1 miles E of Victoria
 (distance) (direction) (nearest town)

description of formations encountered	from	to
Top soil & clay	0	16
sand	16	55
clay	55	60
sand & clay	60	80
clay	80	88
sand	88	145

WELL PURPOSE: Home
 (home, irrigation, municipal, industrial)

WELL COMPLETION DATA:

(1) diameter (inches) 4"

(2) total depth (feet) 145

(3) static water level (feet) 95' above top of ground.

(4) casing plastic 135'
 (material) (depth)
4"
 (size) If telescope see back.

(5) screen 10' 135'
 (length) (depth to top)
4" - 013 plastic
 (size) (material)

(6) pump 1/2 16
 (HP) (yield gpm)
Electric
 (type power)

(7) electric log no
 (yes or no)

(organization running log)


(8) how well bottom plugged plastic cap

DRILLERS REMARKS:

RECEIVED
 JUL - 7 1976
 MISS. Bd. OF WATER COMM

If well telescopes please sketch and show depths.

GROUND LEVEL

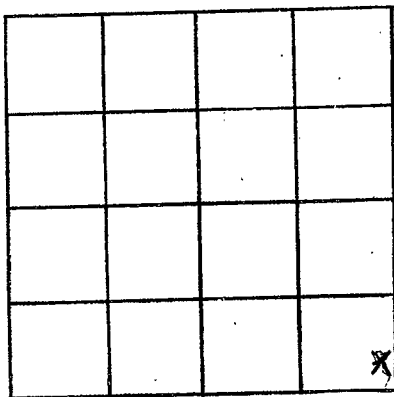

SECTION 3

Please indicate well location X.

ADDITIONAL INFORMATION

If more than one screen,
show locations of each on sketch.