

MARSHALL

2015

7-7-76

MISSISSIPPI BOARD OF WATER COMMISSIONERS
416 North State Street
Jackson, Mississippi 39201

WATER WELL DRILLERS LOG

July 7, 1976 R.L. Carpenter Marshall
date well completed firm name county well located

LANDOWNER: Morris Tenay

Victoria, Miss.

RFD

(mailing address)

WELL LOCATION:

sec. 17 T-3 N R-4 E
2 miles South of Victoria
(distance) (direction) (nearest town)

WELL PURPOSE: Home
(home, irrigation, municipal, industrial)

WELL COMPLETION DATA:

- (1) diameter (inches) 4
- (2) total depth (feet) 165
- (3) static water level (feet) 166 below above top of ground.
- (4) casing Plastic 159'
(material) (depth)
(size) if telescope see back.
- (5) screen 16' 155'
(length) (depth to top)
4 in. Plastic
(size) (material)
- (6) pump 1/2 8
(HP) (yield gpm)
Elec.
(type power)
- (7) electric log No
(yes or no)

(organization running log)

(8) how well bottom plugged Plastic Cap

description of formations encountered

from

to

<u>Surface Soil</u>	<u>0</u>	<u>18</u>
<u>red Red Sand</u>	<u>18</u>	<u>40</u>
<u>red white Sand</u>	<u>40</u>	<u>88</u>
<u>white clay</u>	<u>88</u>	<u>165</u>
<u>white Fine Sand</u>	<u>165</u>	<u>136</u>
<u>white coarse Sand</u>	<u>136</u>	<u>165</u>

DRILLERS REMARKS:


RECEIVED

MAY 12 1978

MISS. RD. OF WATER COMMISSIONERS

If well telescopes please sketch and show depths.

GROUND LEVEL

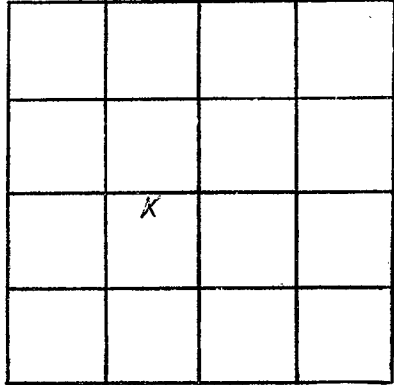

SECTION 12

Please indicate well location X.

ADDITIONAL INFORMATION

If more than one screen,
show locations of each on sketch.