

Marshall  
J 2021  
Nov. 18, 1976

MISSISSIPPI  
 BOARD OF WATER COMMISSIONERS  
 416 North State Street  
 Jackson, Mississippi 39201

WATER WELL DRILLERS LOG

Nov 18 1976 Emel Jones Well Co Marshall  
 date well completed firm name county well located

LANDOWNER:  
Joseph A. Turman  
Holly Springs Miss. Rt.  
 (mailing address)

WELL LOCATION:  
 sec. 26 T 3 N R 4 E  
2 1/2 miles SW. of Red Banks  
 (distance) (direction) (nearest town)

description of formations encountered	from	to
Top soil + clay	0	18
sand	18	44
clay	44	49
sand	49	82
clay	82	88
sand	88	118
clay	118	122
sand	122	165

WELL PURPOSE: Home  
 (home, irrigation, municipal, industrial)

WELL COMPLETION DATA:

(1) diameter (inches) 4"

(2) total depth (feet) 165

(3) static water level (feet) 120 below above top of ground.

(4) casing plastic 155  
 (material) (depth)

4" If telescope see back.  
 (size)

(5) screen 10' 155  
 (length) (depth to top)

4" - DB plastic  
 (size) (material)

(6) pump 1/2 16  
 (HP) (yield gpm)

Electric  
 (type power)

(7) electric log no  
 (yes or no)

(organization running log)

(8) how well bottom plugged plastic cap


DRILLERS REMARKS:

**RECEIVED**

DEC 21 1976

If well telescopes please sketch and show depths.

GROUND LEVEL

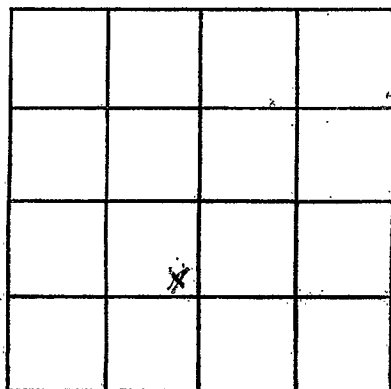

SECTION 26

Please indicate well location X.

ADDITIONAL INFORMATION

If more than one screen,  
show locations of each on sketch.