

MARSHALL  
J 2022  
12/2/76

MISSISSIPPI  
 BOARD OF WATER COMMISSIONERS  
 416 North State Street  
 Jackson, Mississippi 39201

WATER WELL DRILLERS LOG

12-2 19 76 Hicks Well Co. Marshall  
 date well completed firm name county well located

LANDOWNER: Earnest R. Van C...  
Rt. 3  
Buhadin, Mrs.  
 (mailing address)

WELL LOCATION:  
 sec. 10 T. 3 N. R. 4 E.  
42 miles S of Victoria  
 (distance) (direction) (nearest town)

WELL PURPOSE: Home  
 (home, irrigation, municipal, industrial)

WELL COMPLETION DATA:

(1) diameter (inches) 4

(2) total depth (feet) 135

(3) static water level (feet) 90 below above top of ground.

(4) casing PVC, 1.35  
 (material) (depth)  
 (size) if telescope see back.

(5) screen 7, 128  
 (length) (depth to top)  
4", Chavel type  
 (size) (material)

(6) pump 1/2, 10  
 (HP) (yield gpm)  
220V  
 (type power)

(7) electric log No  
 (yes or no)

(organization running log)

(8) how well bottom plugged Cap

description of formations encountered	from to	
	feet	feet
Clay	0	15
Red Sand	15	30
White Sand + Clay	30	90
White Sand	90	135

**RECEIVED**


JAN 1 1977

MISS. BD. OF WATER COMMISSIONERS

DRILLERS REMARKS:

If well telescopes please sketch and show depths.

GROUND LEVEL

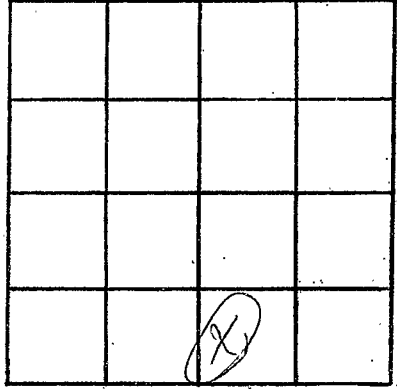

SECTION

10

Please indicate well location X:

ADDITIONAL INFORMATION

If more than one screen,  
show locations of each on sketch.