

MARSHALL
J 2023
2-21-77

MISSISSIPPI
BOARD OF WATER COMMISSIONERS
 416 North State Street
 15E Jackson, Mississippi 39201

WATER WELL DRILLERS LOG

2-21 19 **W.R. Mason** **Marshall**
 date well completed firm name county well located


LANDOWNER:	description of formations encountered	from	to
<i>Ethel Jones</i>			
<i>RFD - Byhalia Miss</i> (mailing address)	<i>Red sand</i>	<i>8</i>	<i>40</i>
WELL LOCATION: sec. <i>9</i> T. <i>3</i> N. R. <i>4</i> E. <i>1 1/4</i> miles <i>SW</i> of <i>Vintona</i> (distance) (direction) (nearest town)	<i>white clay</i>	<i>40</i>	<i>100</i>
WELL PURPOSE: <i>Home</i> (home, irrigation, municipal, industrial)	<i>white sand</i>	<i>100</i>	<i>153'</i>
WELL COMPLETION DATA:			
(1) diameter (inches) <i>4"</i>			
(2) total depth (feet) <i>153'</i>			
(3) static water level (feet) <i>100'</i> below top of ground.			
(4) casing <i>PVC</i> , <i>143'</i> (material) (depth)			
<i>4"</i> if telescope see back. (size)			
(5) screen <i>10'</i> <i>143'</i> (length) (depth to top)			
<i>4"</i> , <i>PVC</i> (size) (material)			
(6) pump <i>3/4</i> <i>10</i> (HP) (yield gpm)			
<i>electric</i> (type power)			
(7) electric log <i>No</i> (yes or no)			
(organization running log)			
(8) how well bottom plugged <i>cap</i>			
DRILLERS REMARKS:			

RECEIVED
 JUL 7 - 1977

MISS. BB. OF WATER COMMISSIONERS

If well telescopes please sketch and show depths.

GROUND LEVEL

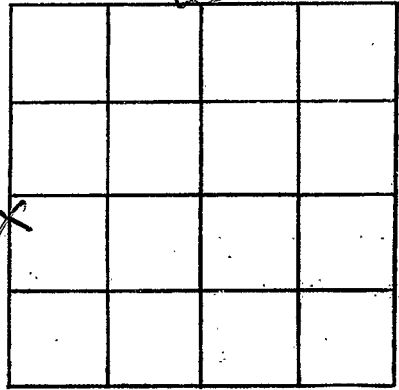

SECTION 9

Please indicate well location X.

ADDITIONAL INFORMATION

If more than one screen, show locations of each on sketch.