

MARSHALL

J 2025

4-8-77

MISSISSIPPI
 BOARD OF WATER COMMISSIONERS
 416 North State Street
 Jackson, Mississippi 39201

15E

WATER WELL DRILLERS LOG

4-8-77

date well completed

19

Earl Jones Well Co

firm name

Marshall

county well located


LANDOWNER:	description of formations encountered	from	to
<i>F. M. Steele</i>			
<i>Holly Springs, Miss. Rt. 3</i> (mailing address)	<i>Topsoil & clay</i>	<i>0</i>	<i>16</i>
	<i>sand</i>	<i>16</i>	<i>24</i>
	<i>clay</i>	<i>14</i>	<i>61</i>
	<i>sand</i>	<i>61</i>	<i>151</i>
WELL LOCATION:			
sec <i>38</i> T <i>3</i> N R <i>4</i> E			
<i>4.7</i> miles S of <i>Red Bank</i>			
(distance) (direction) (nearest town)			
WELL PURPOSE: <i>Home</i>			
(home, irrigation, municipal, industrial)			
WELL COMPLETION DATA:			
(1) diameter (inches) <i>4"</i>			
(2) total depth (feet) <i>151</i>			
(3) static water level (feet) <i>130</i> below top of ground.			
(4) casing <i>Plastic</i> <i>141</i>			
(material) (depth)			
<i>4</i> if telescope see back.			
(size)			
(5) screen <i>10'</i> <i>141</i>			
(length) (depth to top)			
<i>013-4"</i> <i>Plastic</i>			
(size) (material)			
(6) pump <i>1/2</i> <i>15</i>			
(HP) (yield gpm)			
<i>Electric</i>			
(type power)			
(7) electric log <i>no</i>			
(yes or no)			
(organization running log)			
(8) how well bottom plugged <i>Plastic cap</i>			
DRILLERS REMARKS:			

RECEIVED
MAY 10 1977

MISS. BD. OF WATER COMMISSIONERS

If well telescopes please sketch and show depths.

GROUND LEVEL

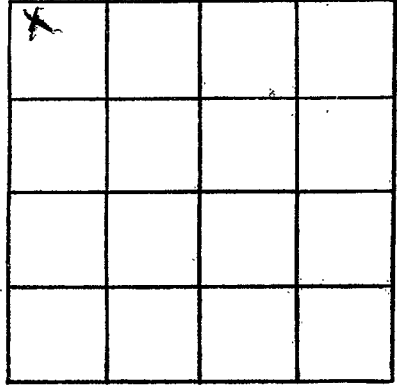

SECTION 34

Please indicate well location X.

ADDITIONAL INFORMATION

If more than one screen, show locations of each on sketch.